IREDELL COUNTY HEALTH DEPARTMENT

STATESVILLE 704-878-5305 MOORESVILLE 704-664-5281

IMPROVEMENT PERMIT / CERTIFICATE OF COMPLETION / OPERATION PERMIT / EXISTING SYSTEM INSPECTION

PROPERTY DESCRIPTION NO. 17254 DATE 3-9-94 TAX MAP NO. 25-A-51 Watershed: ☐ Yes ☐ No

OWNER OR CONTRACTOR KROM FINANCIAL SERVICES PHONE: Business 664-3671 Home 4648-19-3035

ADDRESS 19 YACHT COVE MOORESVILLE NC 28115

LOCATION ON N/S OF CORNELIUS RD WEST OF JUDAS RD

SUBDIVISION MILLS FOREST BLOCK / SECTION II LOT 13 LOT AREA 30,000MIN SITE CLASS. P DESIGN FLOW 360 L.T.A.R. 0.25

Septic Tank: 1000 Gallons; STB 794 Date 3/12/95 ☑ New System ☐ Repair, System Type: I, II, III, IV, V, VI

Pump Tank: Gallons; PT Date System Description: gravity conventional

Pump Make: Model Serial No. Repair System Description: gravity PPBPS

Nitrification Field: No Fields 1 Square Feet 1440 Linear Feet 480 Maintenance Agreement Required: ☐ Yes ☐ No

No Lines 8 Trench Width 36" Max Trench Bottom Depth 24" Gravel Depth 12" ☐ Slab ☑ Crawl Space ☐ Basement w/plumbing ☐ Basement wo/plumbing

☑ House/Mod. Home No. Bedrooms 3

☐ Mobile Home No. Bathrooms 2

☐ Business No. Employees

☐ Other


Water Supply: ☑ Individual ☐ Community ☐ Public

Comments: DO NOT INSTALL DURING WET SOIL CONDITIONS OR RAIN.


Comments:

READY TO ISSUE

INITIAL SITE SKETCH

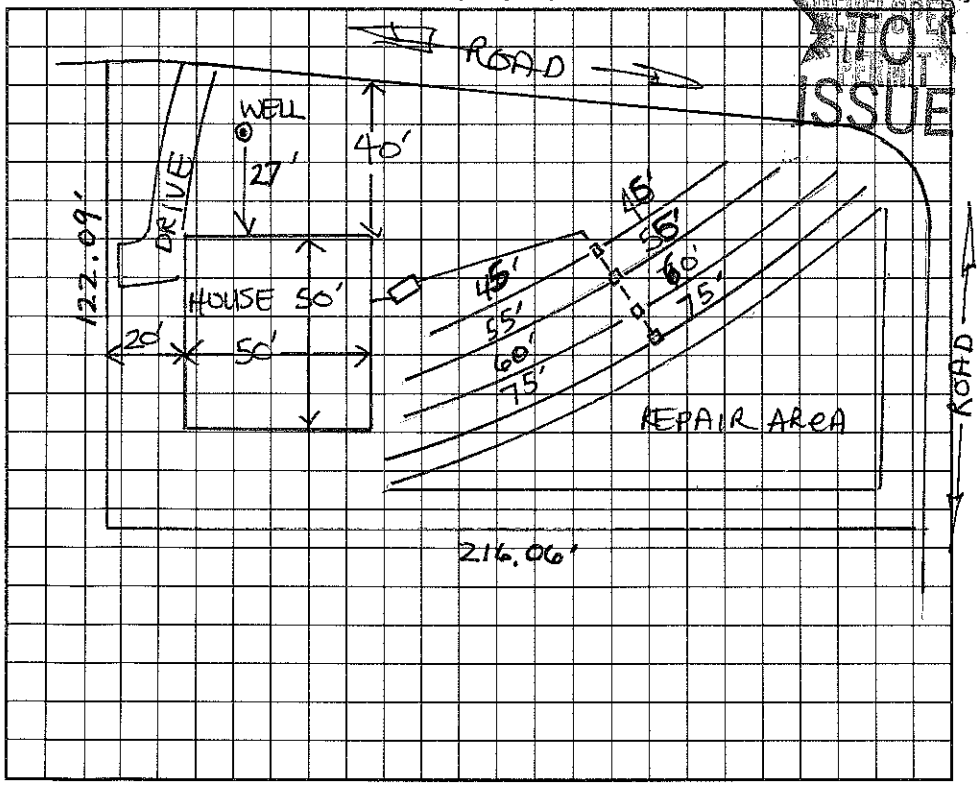

AS BUILT SKETCH

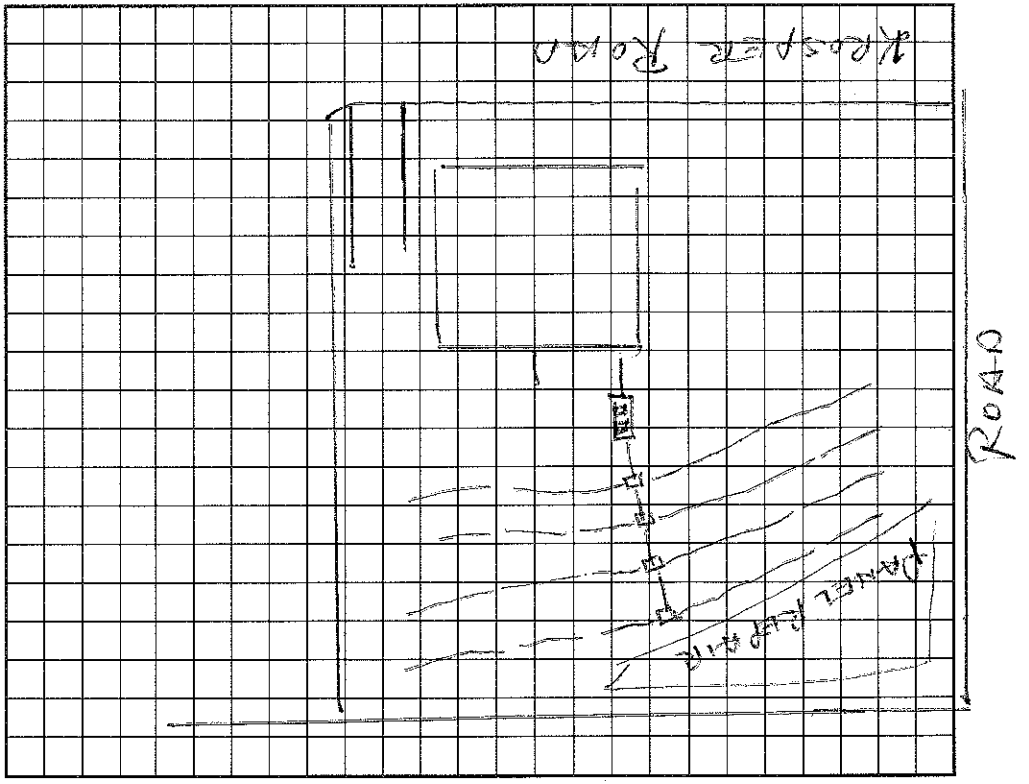

I understand that this permit can be suspended or revoked if any false information is supplied toward securing the permit/any unauthorized changes are made to the site/any unauthorized changes are made in the installation of the system. Improvement Permit is valid for 60 months from date of issuance.

Signed:

Improvement Permit by: Andrea Lemon date 3-9-94

Existing System Inspection by: date

Installed by: Rowan Septic Tank

Certificate of Completion by: Wesley Sparks R.S. date 4/26/95

Operation Permit by: date

HEALTH DEPT. COPY: WHITE INSPECTION COPY (FINAL): GREEN OWNER COPY (FINAL): YELLOW INSPECTION COPY (INITIAL): PINK OWNER COPY (INITIAL): GOLD