IREDELL COUNTY HEALTH DEPARTMENT

STATESVILLE 704-878-5305 MOORESVILLE 704-664-5281

IMPROVEMENT PERMIT / CERTIFICATE OF COMPLETION / OPERATION PERMIT / EXISTING SYSTEM INSPECTION

PROPERTY DESCRIPTION NO. 17251 DATE 3-9-94 TAX MAP NO. 25-A-51 Watershed: ☐ Yes ☐ No

OWNER OR CONTRACTOR KROM FINANCIAL SERVICES PHONE: Business 664-3671 Home 4648-19-4191

ADDRESS 19 YACHT COVE MOORESVILLE NC 28115

LOCATION ON N/S OF CORNELIUS RD WEST OF JUDAS RD

SUBDIVISION MILLS FOREST BLOCK / SECTION II LOT 12 LOT AREA 20,000MIN SITE CLASS. P DESIGN FLOW 360 L.T.A.R. 0.25

Septic Tank: 1000 Gallons; STB 825 Date 3/11/95
Pump Tank: _____ Gallons; PT _____ Date _____
Pump Make: _____ Model _____ Serial No. _____
Nitrification Field: No Fields 2 Square Feet 1440 Linear Feet 480
No Lines 4 & 5 Trench Width 36" Max Trench Bottom Depth 20-24" Gravel Depth 12"

☒ New System ☐ Repair System Type: I, II, III, IV, V, VI
System Description: gravity, conventional
Repair System Description: gravity conventional
Maintenance Agreement Required: ☐ Yes ☒ No

☒ House/Mod. Home No. Bedrooms 3
☐ Mobile Home No. Bathrooms 2
☐ Business No. Employees ____
☐ Other ____
☐ Slab ☒ Crawl Space ☐ Basement w/plumbing ☐ Basement wo/plumbing

Water Supply: ☒ Individual ☐ Community ☐ Public


Comments: DO NOT INSTALL DURING WET SOIL CONDITIONS OR RAIN. DIRECT DOWNSPOUTS AWAY FROM SYSTEM.

READY 12/5/94 Area

DEVELOPER ISSUE

Comments: Installed as shown on Imp. Permit

INITIAL SITE SKETCH

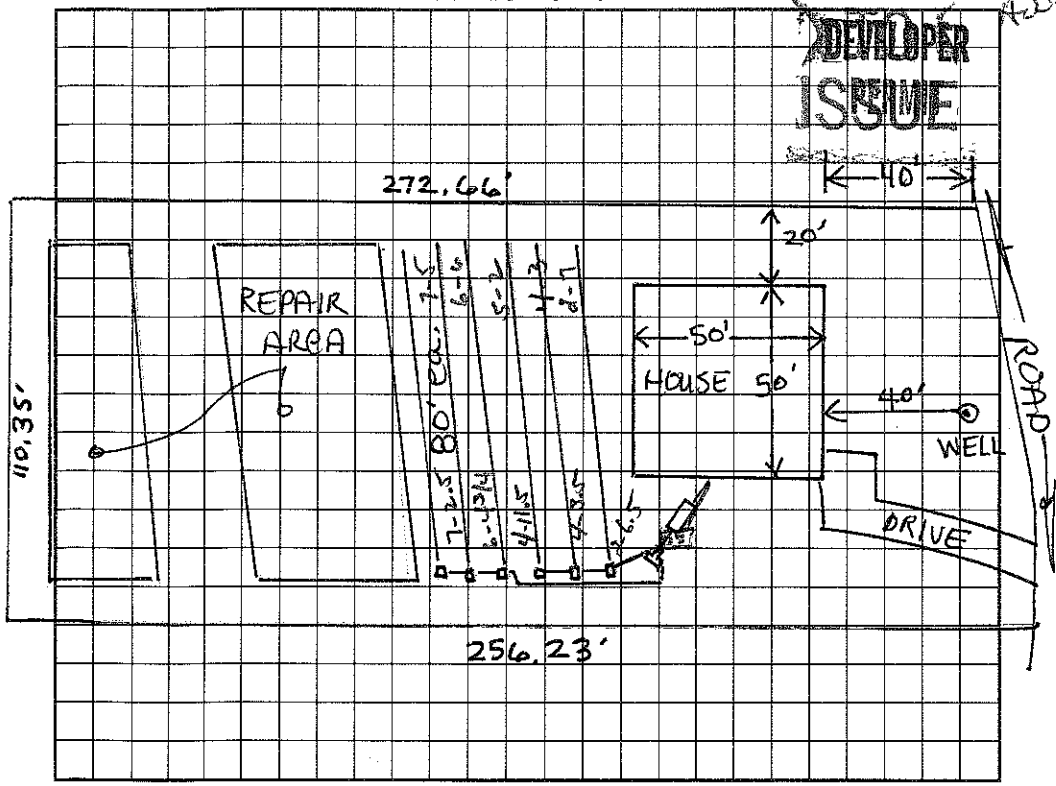

AS BUILT SKETCH

I understand that this permit can be suspended or revoked if any false information is supplied toward securing the permit/any unauthorized changes are made to the site/any unauthorized changes are made in the installation of the system. Improvement Permit is valid for 60 months from date of issuance.

Signed: _____

Improvement Permit by: Andrea Lemon date 3-9-94

Existing System Inspection by: _____ date _____

Installed by: Roman Septic Tank

Certificate of Completion by: Wesley Sparks RS date 6/13/95

Operation Permit by: _____ date _____

HEALTH DEPT. COPY: WHITE INSPECTION COPY (FINAL): GREEN OWNER COPY (FINAL): YELLOW INSPECTION COPY (INITIAL): PINK OWNER COPY (INITIAL): GOLD