IREDELL COUNTY HEALTH DEPARTMENT

SVILLE 704-878-5305 MOORESVILLE 704-664-5281

IMPROVEMENT PERMIT / CERTIFICATE OF COMPLETION / OPERATION PERMIT / EXISTING SYSTEM INSPECTION

PROPERTY DESCRIPTION NO. 17327 DATE 3-9-94 TAX MAP NO. 25-A-51 4648 194698 Watershed: ☐ Yes ☐ No

OWNER OR CONTRACTOR KROM FINANCIAL SERVICES PHONE: Business 664-3671 Home

ADDRESS 19 Yacht Cove Mooresville NC 28115

LOCATION north side of Cornelius road west of Judas road

SUBDIVISION MILLS FOREST BLOCK / SECTION II LOT 23 LOT AREA 20,000min SITE CLASS. P DESIGN FLOW 360 L.T.A.R. 0.25

292.71'

Septic Tank: 1000 Gallons; STB 825 Date 1-5-95

Pump Tank: 1000 Gallons; PT 47 Date 12-15-94

Pump Make: ZOELLER Model N137 Serial No. 1994-11-08

Nitrification Field: No Fields 2 Square Feet 1440 Linear Feet 480

No Lines 7 Trench Width 36" Max Trench Bottom Depth 20" Gravel Depth 12"

☐ New System ☐ Repair System Type: I, II, III, IV, V, VI

System Description: pump/conventional

Repair System Description: PP

Maintenance Agreement Required: ☐ Yes ☒ No

☒ House/Mod. Home No. Bedrooms 3

☐ Mobile Home No. Bathrooms 2

☐ Business No. Employees

☐ Other


☐ Slab ☒ Crawl Space ☐ Basement w/plumbing ☐ Basement wo/plumbing

Water Supply:
☒ Individual
☐ Community
☐ Public

Comments: Do not install during wet soil conditions or rain.
Do not backfill gullies until system has been laid out.
Pump line will require sleeving/other to prevent settling.
MANNER IN WHICH TO REINFORCE PUMP LINE TO BE DETERMINED AT TIME OF INSTALLATION

Comments:

INITIAL SITE SKETCH

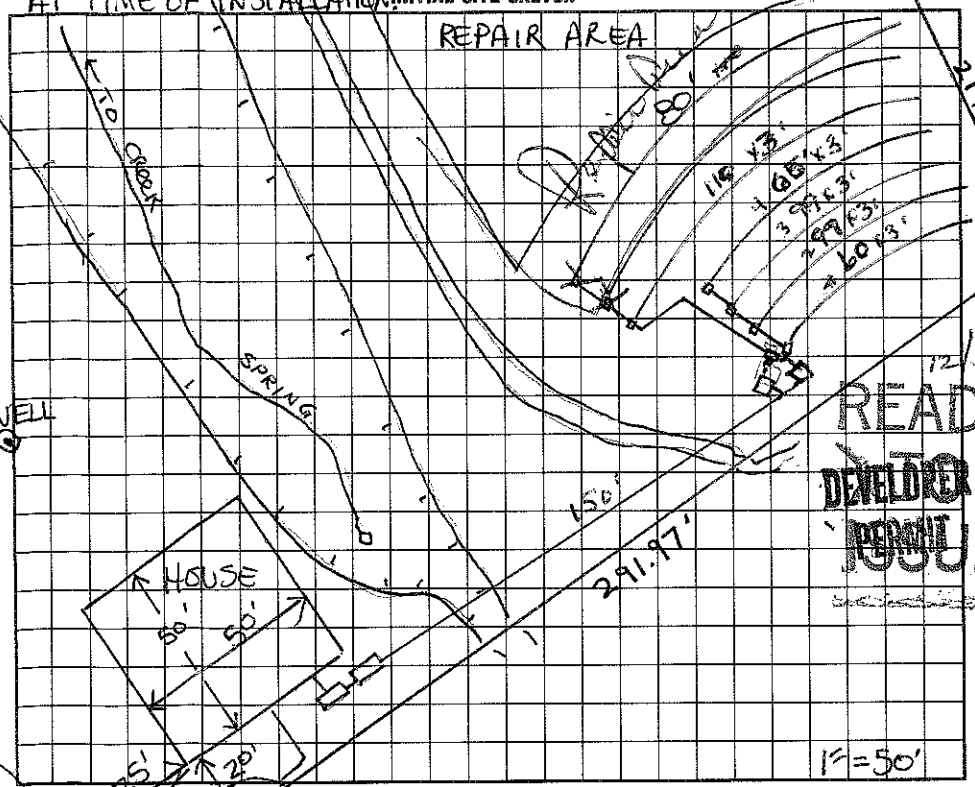

AS BUILT SKETCH

I understand that this permit can be suspended or revoked if any false information is supplied toward securing the permit/any unauthorized changes are made to the site/any unauthorized changes are made in the installation of the system. Improvement Permit is valid for 60 months from date of issuance.

Signed:

Improvement Permit by: Andrea Lemon date 3-10-94

Existing System Inspection by: date

Installed by: Rowan Septic Tank

Certificate of Completion by: Wesley Sparks RS date 3/28/95

Operation Permit by: date

HEALTH DEPT. COPY: WHITE INSPECTION COPY (FINAL): GREEN OWNER COPY (FINAL): YELLOW INSPECTION COPY (INITIAL): PINK OWNER COPY (INITIAL): GOLD