IREDELL COUNTY HEALTH DEPARTMENT

STATESVILLE 704-878-5305 MOORESVILLE 704-664-5281

IMPROVEMENT PERMIT / CERTIFICATE OF COMPLETION / OPERATION PERMIT / EXISTING SYSTEM INSPECTION

PROPERTY DESCRIPTION NO. 17232 DATE 3-9-94 TAX MAP NO. 25-A-51 Watershed: ☐ Yes ☐ No

OWNER OR CONTRACTOR KROM FINANCIAL SERVICES PHONE: Business 664-3671 Home

ADDRESS 19 YACHT COVE MOORESVILLE NC 28115

LOCATION ON N/S OF CORNELIUS RD WEST OF JUDAS RD 4648-19-7122

SUBDIVISION MILLS FOREST BLOCK / SECTION II LOT 10 LOT AREA 20,000MIN SITE CLASS. P DESIGN FLOW 360 L.T.A.R. 0.25

Septic Tank: 1000 Gallons; STB 825 Date 1-11-95

Pump Tank: Gallons; PT Date

Pump Make: Model Serial No.

Nitrification Field: No Fields 1 Square Feet 1440 Linear Feet 480

No Lines 4 Trench Width 36" Max Trench Bottom Depth 22" Gravel Depth 12"

☑ New System ☐ Repair, System Type: I, II, III, IV, V, VI

System Description: gravity conventional

Repair System Description: gravity conventional

Maintenance Agreement Required: ☐ Yes ☑ No

☑ House/Mod. Home No. Bedrooms 3

☐ Mobile Home No. Bathrooms 2

☐ Business No. Employees

☐ Other

☐ Slab ☑ Crawl Space ☐ Basement w/plumbing ☐ Basement wo/plumbing


Water Supply: ☑ Individual ☐ Community ☐ Public

Comments: DO NOT INSTALL DURING WET SOIL CONDITIONS OR RAIN, DIRECT DOWNSPOUTS AWAY FROM NIT. FIELD.

Comments:

10/11/94 READY FOR DEVELOPER PERMIT ISSUE

INITIAL SITE SKETCH

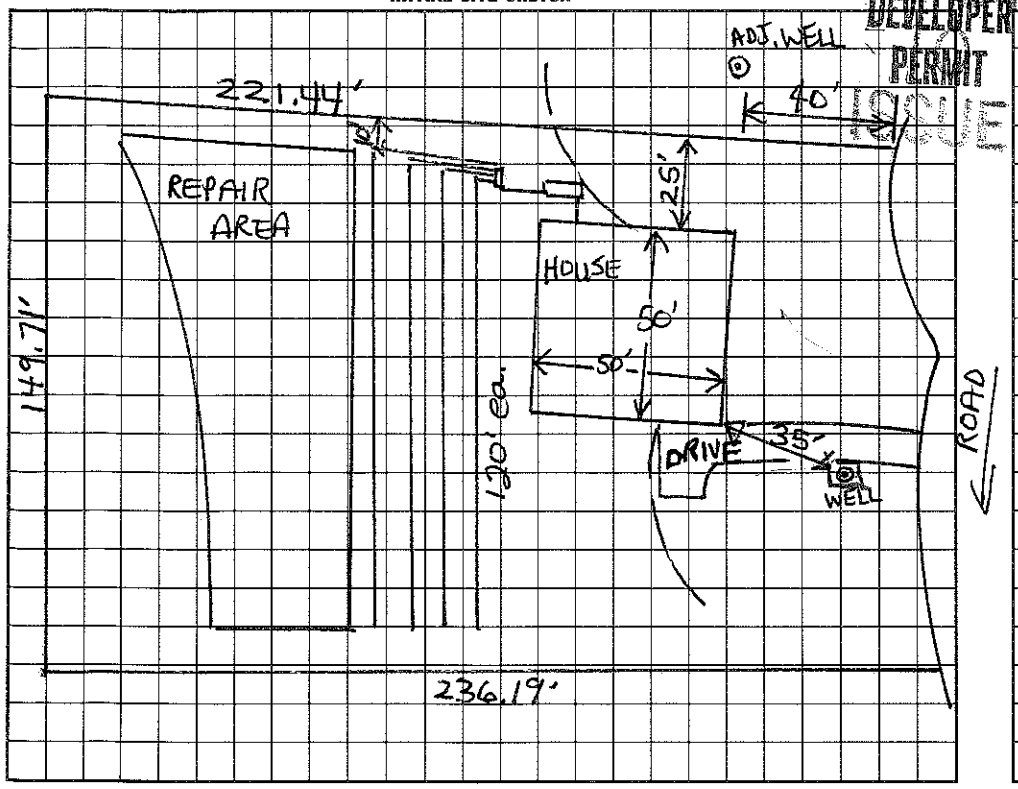

AS BUILT SKETCH

Same as initial sketch

I understand that this permit can be suspended or revoked if any false information is supplied toward securing the permit/any unauthorized changes are made to the site/any unauthorized changes are made in the installation of the system. Improvement Permit is valid for 60 months from date of issuance.

Signed:

Improvement Permit by: Andrea Lemon date 3-9-94

Existing System Inspection by: date

Installed by: Rowan S.T. Co.

Certificate of Completion by: C. Moore date 4-3-95

Operation Permit by: date

HEALTH DEPT. COPY: WHITE INSPECTION COPY (FINAL): GREEN OWNER COPY (FINAL): YELLOW INSPECTION COPY (INITIAL): PINK OWNER COPY (INITIAL): GOLD