IREDELL COUNTY HEALTH DEPARTMENT

STATESVILLE 704-878-5305 MOORESVILLE 704-664-5281

IMPROVEMENT PERMIT / CERTIFICATE OF COMPLETION / OPERATION PERMIT / EXISTING SYSTEM INSPECTION

PROPERTY DESCRIPTION NO. ~~17315~~ 17314 DATE 3-9-94 TAX MAP NO. 25-A-51 Watershed: ☐ Yes ☐ No

OWNER OR CONTRACTOR Krom Financial Services PHONE: Business 664-3671 Home 4648-19-7356

ADDRESS 19 Yacht Cove Mooresville NC 28115

LOCATION north side of Cornelius road west of Judas road

SUBDIVISION Mills Forest BLOCK / SECTION II LOT 17 LOT AREA 20,000min SITE CLASS. P DESIGN FLOW 360 L.T.A.R. 0.25

Septic Tank: 1000 Gallons; STB 325 Date 6/27/94
Pump Tank: ____ Gallons; PT ____ Date ____
Pump Make: ____ Model ____ Serial No. ____
Nitrification Field: No Fields ~~2~~ 1 Square Feet 1440 Linear Feet 480
No Lines ~~6~~ 7 Trench Width 36" Max Trench Bottom Depth 20" Gravel Depth 12"

☒ New System ☐ Repair System Type: I, II, III, IV, V, VI
System Description: gravity conventional
Repair System Description: low pressure pipe
Maintenance Agreement Required: ☐ Yes ☒ No

☒ House/Mod. Home No. Bedrooms 3
☐ Mobile Home No. Bathrooms 2
☐ Business No. Employees ____
☐ Other ____


☐ Slab ☒ Crawl Space ☐ Basement w/plumbing ☐ Basement wo/plumbing

Water Supply:
☒ Individual
☐ Community
☐ Public


Comments: Do not insatll during wet soil conditiona or rain. direct downspouts away from nit. field

Comments: Changed to set on contour - I.P. had running uphill behind house

INITIAL SITE SKETCH

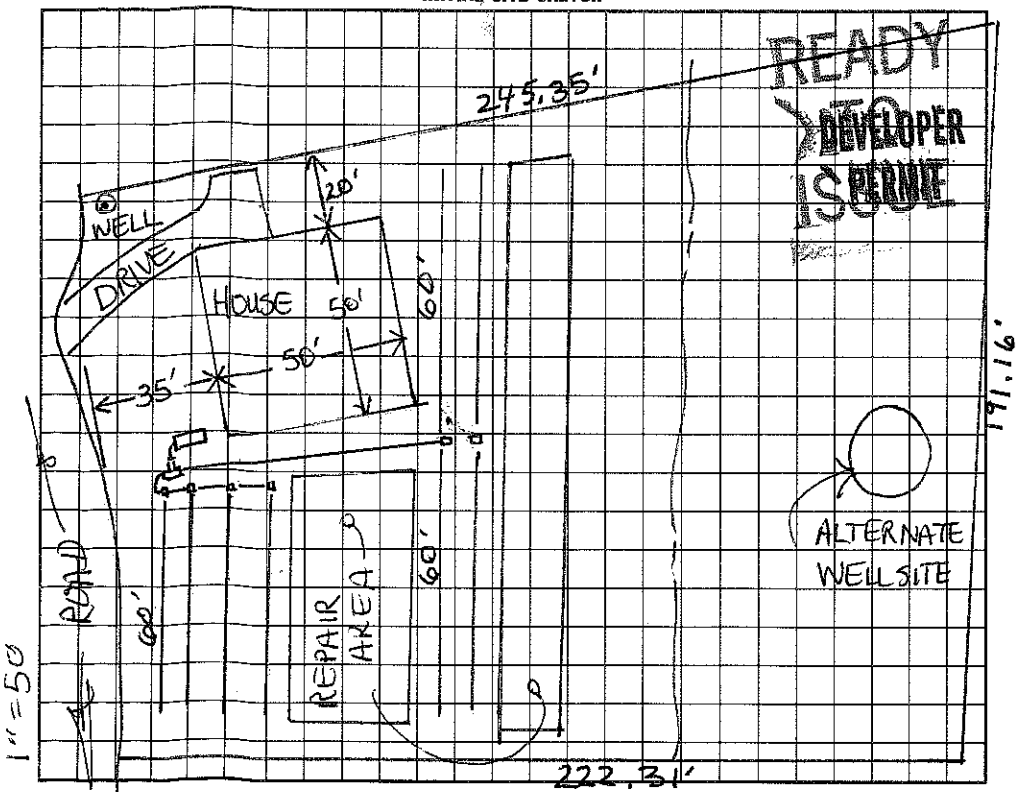

AS BUILT SKETCH

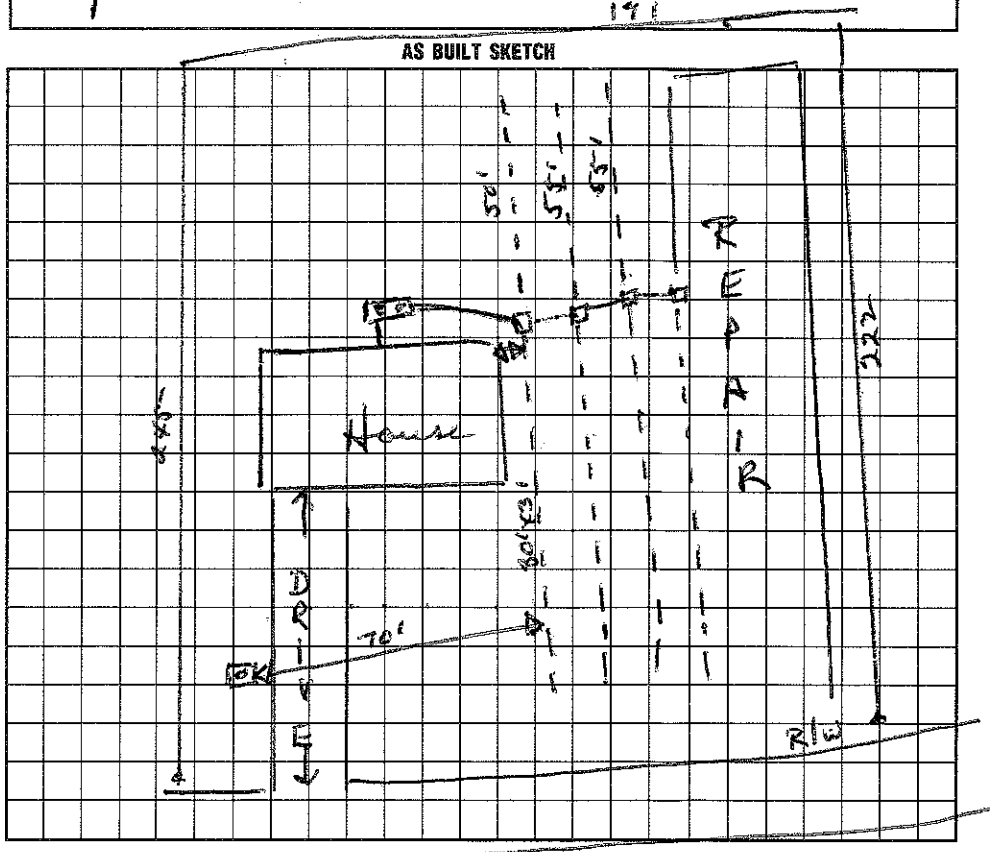

I understand that this permit can be suspended or revoked if any false information is supplied toward securing the permit/any unauthorized changes are made to the site/any unauthorized changes are made in the installation of the system. Improvement Permit is valid for 60 months from date of issuance.

Signed: ____

Improvement Permit by: Andrea Lemon date 3-10-94

Existing System Inspection by: ____ date ____

Installed by: Rowan Septic Tank

Certificate of Completion by: Wesley Sparks RS. date 10/5/94

Operation Permit by: ____ date ____

HEALTH DEPT. COPY: WHITE INSPECTION COPY (FINAL): GREEN OWNER COPY (FINAL): YELLOW INSPECTION COPY (INITIAL): PINK OWNER COPY (INITIAL): GOLD