IREDELL COUNTY HEALTH DEPARTMENT

STATESVILLE 704-878-5305 MOORESVILLE 704-664-5281

IMPROVEMENT PERMIT / CERTIFICATE OF COMPLETION / OPERATION PERMIT / EXISTING SYSTEM INSPECTION

PROPERTY DESCRIPTION NO. ~~17325~~ 17324 DATE 3-9-94 TAX MAP NO. 25-A-51 Watershed: ☐ Yes ☐ No

OWNER OR CONTRACTOR KROM FINANCIAL SERVICES PHONE: Business 664-3671 Home 4648-19-9615

ADDRESS 19 Yacht Cove Mooresville NC 28115

LOCATION north side of Cornelius road west of Judas road

SUBDIVISION MILLS FOREST BLOCK / SECTION II LOT 20 LOT AREA 20,000min SITE CLASS. P DESIGN FLOW 360 L.T.A.R. 0.25

Septic Tank: ~~1000~~ Gallons; STB ~~825~~ Date ~~4/6/95~~

Pump Tank: Gallons; PT Date

Pump Make: Model Serial No. ~~440~~

Nitrification Field: No Fields 1 Square Feet 1440 Linear Feet ~~480~~

No Lines 4 Trench Width 36" Max Trench Bottom Depth 24"

☑ New System ☐ Repair System Type: I, II, III, IV, V, VI

System Description: ~~gravity conventional~~

Repair System Description: gravity conventional

Maintenance Agreement Required: ☐ Yes ☒ No

Gravel Depth 12"

☒ House/Mod. Home No. Bedrooms 3

☐ Mobile Home No. Bathrooms 2

☐ Business No. Employees

☐ Other

☐ Slab ☒ Crawl Space ☐ Basement w/plumbing ☐ Basement wo/plumbing


Water Supply: ☒ Individual ☐ Community ☐ Public

Comments: Do not install during wet soil conditions or rain.
Direct downspouts away from nit. field


Comments: Original layout used - house location not changed as build site had requested

READY TO DEVELOPER ISSUE

INITIAL SITE SKETCH

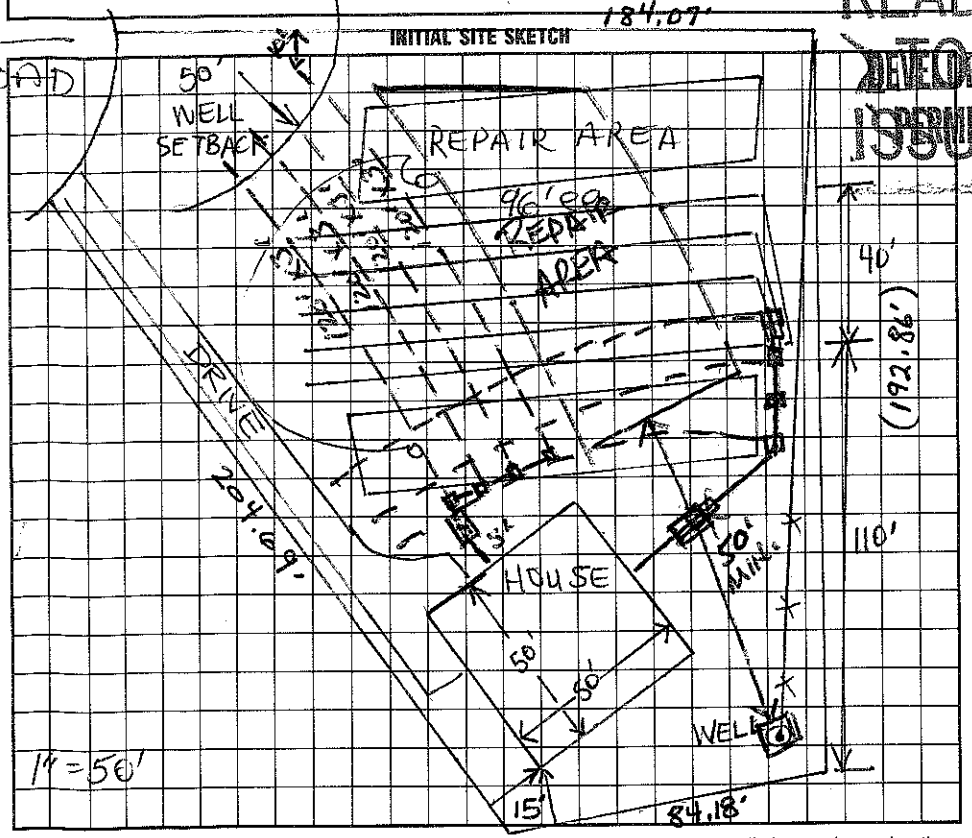

AS BUILT SKETCH

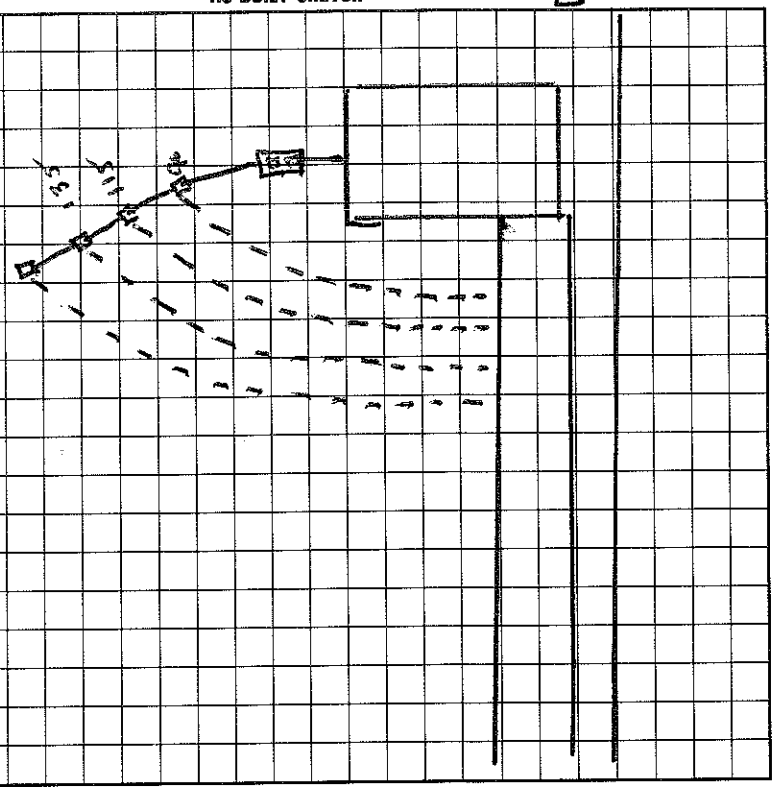

I understand that this permit can be suspended or revoked if any false information is supplied toward securing the permit/any unauthorized changes are made to the site/any unauthorized changes are made in the installation of the system. Improvement Permit is valid for 60 months from date of issuance.

Signed: Wesley Sparks RS.

Improvement Permit by: Andrea Lemon date 3-10-94

Existing System Inspection by: date

Installed by: Rowan Septic Tank

Certificate of Completion by: Wesley Sparks RS date 7/5/95

Operation Permit by: date

HEALTH DEPT. COPY: WHITE INSPECTION COPY (FINAL): GREEN OWNER COPY (FINAL): YELLOW INSPECTION COPY (INITIAL): PINK OWNER COPY (INITIAL): GOLD