4648 21 1694

IREDELL COUNTY HEALTH DEPARTMENT

→ AUTHORIZATION TO CONSTRUCT

2:00

STATESVILLE 704-878-5305 MOORESVILLE 704-664-5281

IMPROVEMENT PERMIT / ~~CERTIFICATE OF COMPLETION~~ / OPERATION PERMIT / EXISTING SYSTEM INSPECTION

PROPERTY DESCRIPTION NO. Repair DATE 1/22/97 TAX MAP NO. REPAIR Watershed: ☐ Yes ☐ No

OWNER OR CONTRACTOR DAN FRYE PHONE: Business _____ Home 663-3847

ADDRESS 144 McINNIS RD MOORESVILLE NC 28115

LOCATION BLUEFIELD RD - TL BIG INDIAN - STAY STRAIGHT - TL McINNIS - LAST HOUSE ON RT

SUBDIVISION — BLOCK / SECTION — LOT — LOT AREA ≈ 2 AC SITE CLASS. PS DESIGN FLOW 360GPD L.T.A.R. —

Septic Tank: EXISTING Gallons; STB _____ Date _____

Pump Tank: _____ Gallons; PT _____ Date _____

Pump Make: _____ Model _____ Serial No. _____

Nitrification Field: No Fields ___ Square Feet 450 Linear Feet 150

No Lines 3 @ 50' Trench Width 36" Max Trench Bottom Depth AS NEEDED ~~Gravel Depth~~ SAND

☐ New System ☑ Repair System Type: I, II, (III), IV, V, VI

System Description: _____

Repair System Description: GRAVITY CHAMBERED

Maintenance Agreement Required: ☐ Yes ☑ No

☑ House/Mod. Home No. Bedrooms 3

☐ Mobile Home No. Bathrooms 4

☐ Business No. Employees ___

☐ Other _____


☐ Slab ☑ Crawl Space ☐ Basement w/plumbing ☐ Basement wo/plumbing

Water Supply: ☑ Individual ☐ Community ☐ Public


Comments: 3 LINES AT 50' - CHAMBERED SYSTEM

Comments:

INITIAL SITE SKETCH

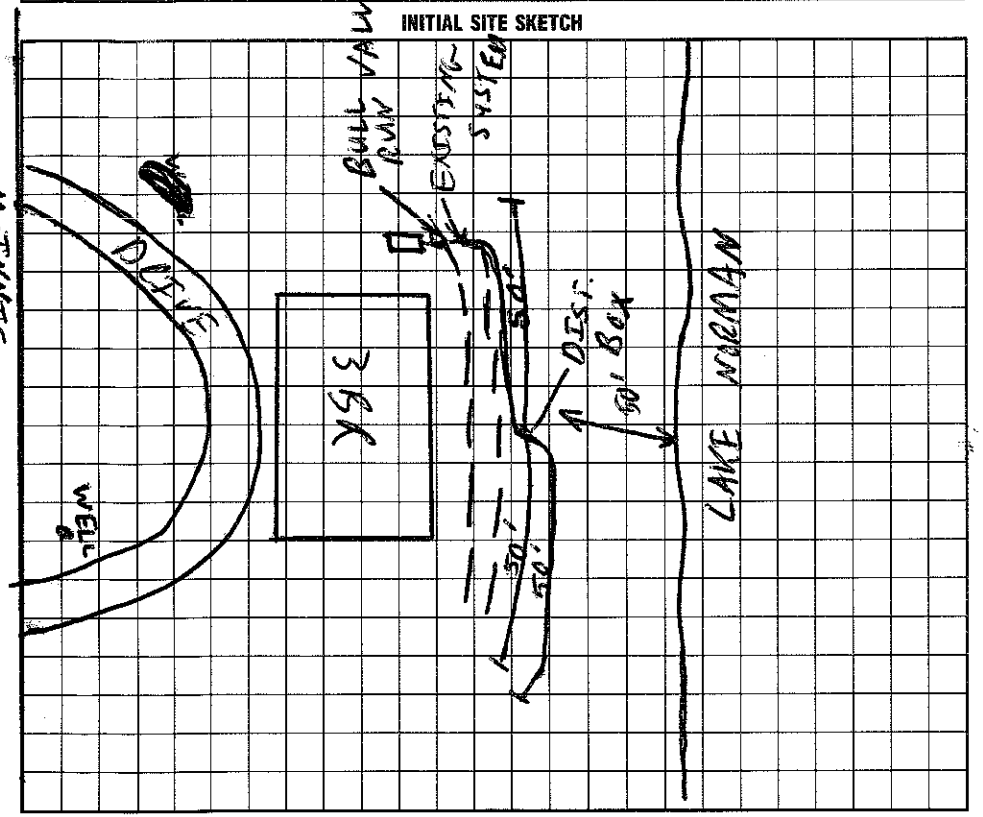

AS BUILT SKETCH

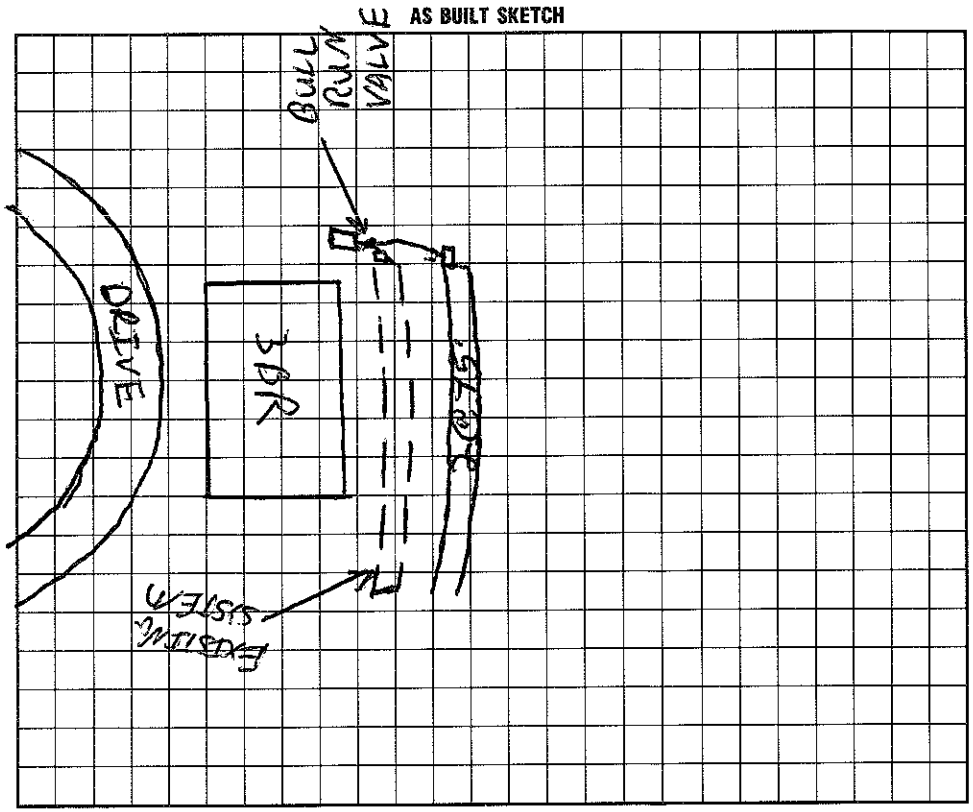

I understand that this permit can be suspended or revoked if any false information is supplied toward securing the permit/any unauthorized changes are made to the site/any unauthorized changes are made in the installation of the system. Improvement Permit is valid for 60 months from date of issuance.

Signed: Stephanie V. Frye

Installed by: FJ ERVIN

Improvement Permit by: C. Ray Thompson EHSI date 1/22/97

Certificate of Completion by: _____ date _____

AUTHORIZATION TO CONSTRUCT ~~Existing System Inspection~~ by: C. Ray Thompson EHSI date 1/22/97

Operation Permit by: C. Ray Thompson date 4/2/97

HEALTH DEPT. COPY: WHITE INSPECTION COPY (FINAL): GREEN OWNER COPY (FINAL): YELLOW INSPECTION COPY (INITIAL): PINK OWNER COPY (INITIAL): GOLD