Site Address: 150 McInnis Rd - Mrsvl.

IREDELL COUNTY HEALTH DEPARTMENT

STATESVILLE 704-878-5305 MOORESVILLE 704-664-5281

IMPROVEMENT PERMIT / AUTHORIZATION TO CONSTRUCT / OPERATION PERMIT / EXISTING SYSTEM INSPECTION

PERMIT# 122326 PIN# 4648-21-3608 DATE 7-28-04

OWNER OR CONTRACTOR BD of NORTH CAROLINA, INC. PHONE Business 704-696-2662 Home

ADDRESS 249 WILLIAMSON ROAD, MOORESVILLE, NC 28117 (SUITE 101)

LOCATION NC 150 WEST, TR BLUEFIELD ROAD, TL BIG INDIAN LOOP, TL McINNIS ROAD, 3RD on RIGHT BEHIND ENA

SUBDIVISION JAMES L. SMITH BLOCK / SECTION LOT 3 LOT AREA 0.57 ACRE SITE CLASS PS DESIGN FLOW 360' L.T.A.R. EXISTING

Septic Tank 1000 Gallons: ST# Date

Pump Tank Gallons: PT Date

Pump Make Model Serial No.

Nitrification Field: No Fields 1 Square Feet 625 Linear Feet 125

No Lines 1 BED Trench Width 5' Max Trench Bottom Depth Gravel Depth 10"

☐ New System ☒ Repair System Type: I (II, III, IV, V)

System Description: CONVENTIONAL, GRAVITY

Repair System Description: 30% REDUCTION, LOW-PRESSURE

Maintenance Agreement Required: ☐ Yes ☒ No

☒ House/Mod. Home No. Bedrooms 3

☐ Mobile Home No. Bathrooms

☐ Business No. Employees

☐ Other


☐ Slab ☒ Crawl Space ☐ Basement w/plumbing ☐ Basement w/o plumbing

Water Supply: ☐ Individual ☐ Public ☐ Community


Comments/Conditions:

Comments/Conditions: ① SYSTEM SIZED TO ACCOMODATE 3 BEDROOMS ONLY ② KEEP NEW WELL MINIMUM 100' FROM SYSTEM, REPAIR AREA, AND NEIGHBORING SYSTEM (LOT #2) ③ SYSTEM UNDERSIZED ACCORDING TO TODAY'S STANDARDS

INITIAL SITE SKETCH

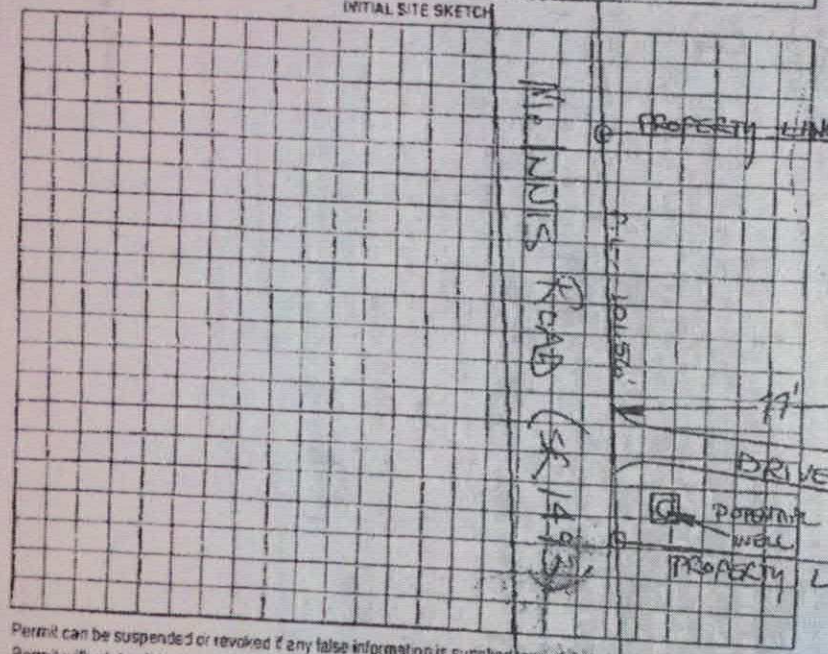

AS BUILT SKETCH

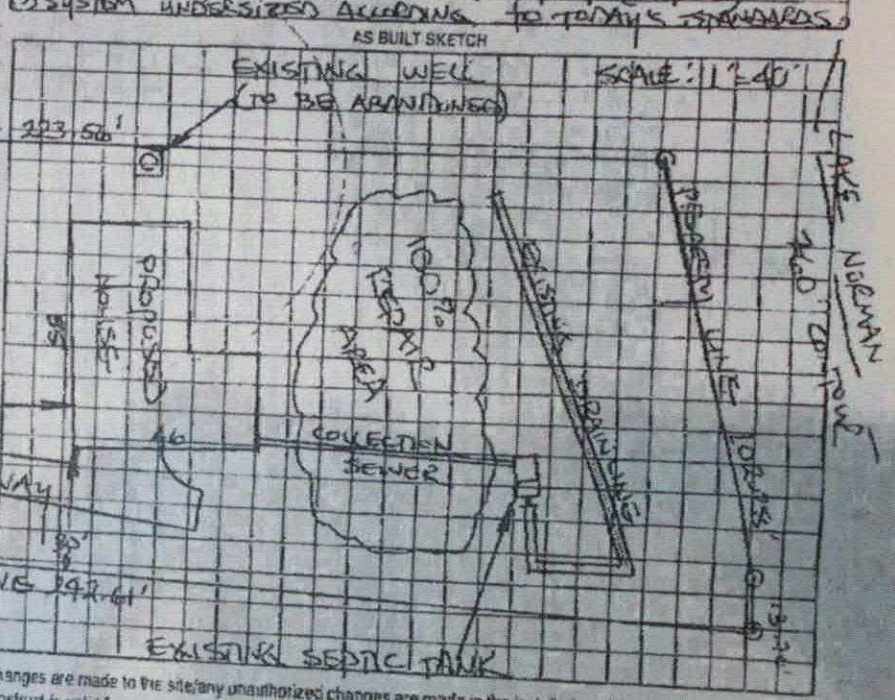

Permit can be suspended or revoked if any false information is supplied toward securing the permit/any unauthorized changes are made to the site/any unauthorized changes are made in the installation of the system. Improvement Permit will not be valid without expiration. Improvement Permit with site plan valid for sixty months. Authorization to Construct is valid for a period equal to that of Improvement Permit – not to exceed sixty months.

Signed Deanne Landrum date 8-3-04

Improvement Permit by date Installed by:

Authorization to Construct by date Operation Permit by date

Existing System Inspection by: STEVE HENDRICK date 7-28-04

HEALTH DEPT COPY: WHITE OWNER COPY (FINAL): YELLOW OWNER COPY (INITIAL): PINK

PAGE 01/01 7-27-04 (C)

S/D: Stutts View

12/17/2008 02:41 704-6649737