IREDELL COUNTY HEALTH DEPARTMENT - *ENVIRONMENTAL HEALTH* ☐ STATESVILLE OFFICE 704-878-5305 ☒ MOORESVILLE OFFICE 704-664-5281

IMPROVEMENT PERMIT / AUTHORIZATION TO CONSTRUCT / OPERATION PERMIT / EXISTING SYSTEM INSPECTION

PERMIT # 169767 PIN # 4648-21-3608 DATE 12-29-11

OWNER Kyle Thomas APPLICANT: SAME PHONE: Home/Cell # (007-780-4884 Business #

SITE ADDRESS 150 McInnis OWNER / APPLICANT ADDRESS SAME

SITE DIRECTIONS Bluefield, Big Indian, McInnis, (R)

SUBDIVISION Stutts View BLOCK / SECTION LOT # 3 LOT AREA .57 Ac DESIGN FLOW [redacted] L.T.A.R.

Septic Tank EXISTING Gallons: STB Date

Pump Tank Gallons: P T Date

Pump Make Model Serial #

No. Nitrification Fields: No. Lines EXISTING Linear Feet

Trench Width Max. Trench Bottom Depth Gravel Depth

☐ New System ☐ Repair ☐ Expansion System Type I II III IV V VI

System Description: CONVENTIONAL

Repair System Description: 25%

Maintenance Agreement Required ☐ YES ☒ NO

☒ GRAVITY ☐ PRESSURE

☐ Residence No. Bedrooms 3

☐ Business No. Persons

☒ Other No. Employees

☐ Slab ☒ Crawl Space

☐ Basement w/plumbing ☐ Basement w/o plumbing

Water Supply
☒ Private
☐ Public
☐ Community

Comments / Conditions: SYSTEM INSPECTION FOR DECK ONLY
SYSTEM UNDERSIZED FOR 3 BR

DECK

INITIAL SITE SKETCH


The proposed / ~~existing~~ Garage addition does not appear to impact the existing septic system.

**NOTE: 1/2 Bath only


Judy Melville R.S.

Date: 2-1-13

ICHD-Environmental Health Division

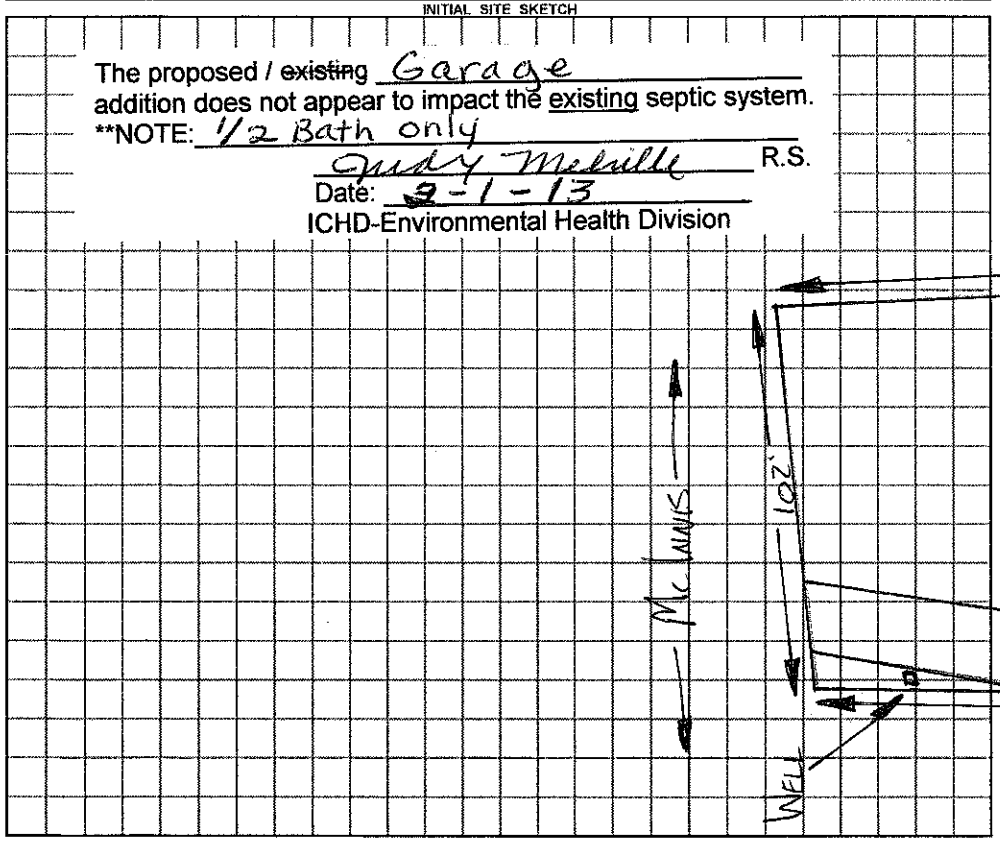

AS BUILT SKETCH

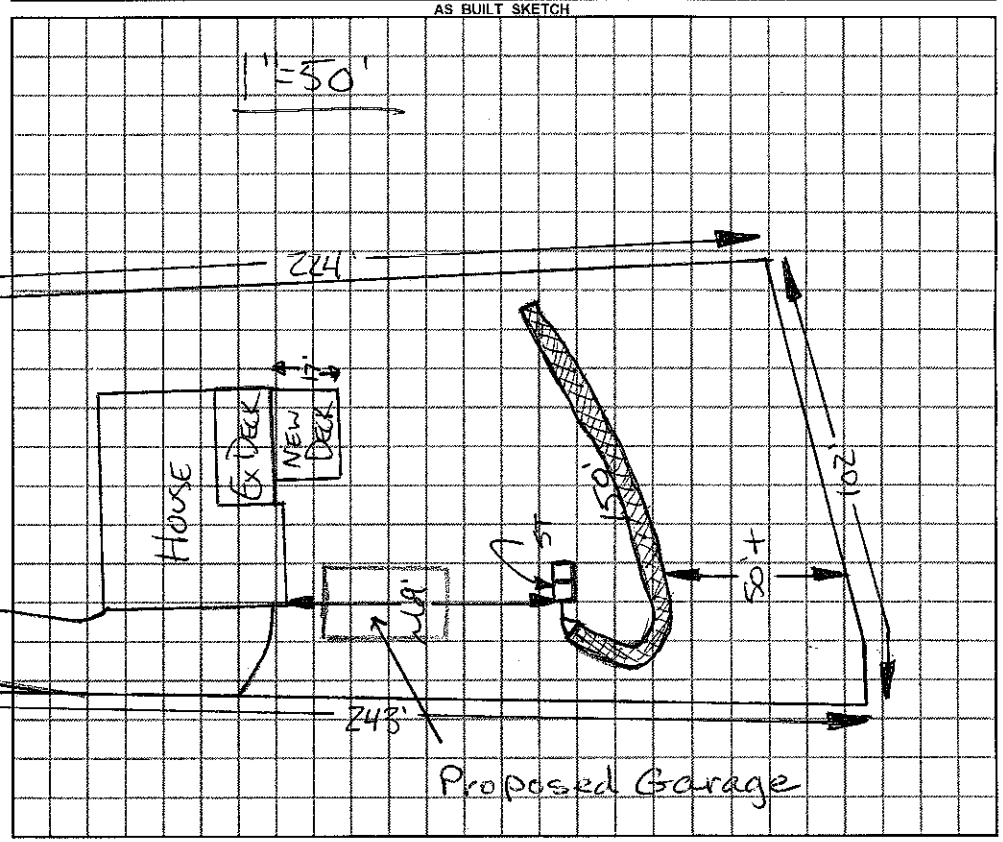

Permit can be suspended or revoked if any false information is supplied toward securing the permit / any unauthorized changes are made to the site / any unauthorized changes are made in the installation of the system.

☐ ***IMPROVEMENT PERMIT*** *with plat valid without expiration.* ☐ ***IMPROVEMENT PERMIT*** *with ~~plat valid without expiration.~~ site plan valid 60 mo.* ☐ ***AUTHORIZATION TO CONSTRUCT*** valid for period equal to IMPROVEMENT PERMIT--not to exceed 60 mo.

Owner / Applicant Signature: Kyle Thomas Date

IMPROVEMENT PERMIT by: REHS Date

AUTHORIZATION TO CONSTRUCT by: REHS Date

YOU SHOULD CONTACT A LOCATOR SERVICE PRIOR TO ANY EXCAVATION

Installed by:

OPERATION PERMIT by: REHS Date

Existing System Inspected by: REHS Date 12-29-11

White Copy – Environmental YELLOW COPY (Final) Owner / Applicant PINK COPY (Initial) Owner / Applicant