IREDELL COUNTY HEALTH DEPARTMENT

STATESVILLE 704-878-5305 375, Pd MOORESVILLE 704-664-5281

IMPROVEMENT PERMIT / AUTHORIZATION TO CONSTRUCT / OPERATION PERMIT / EXISTING SYSTEM INSPECTION

PERMIT# 122325 PIN# 4648-21-4712 DATE 7-28-04

OWNER OR CONTRACTOR BO OF NORTH CAROLINA, INC PHONE: Business 704-696-2662 Home

ADDRESS 249 WILLIAMSON ROAD, MOORESVILLE, NC 28117 (SUITE 101)

LOCATION NC 150 WEST, TR BLUEFIELD ROAD, TL BIG INDIAN LOOP, TL McINNIS ROAD, 2ND LOT ON RIGHT FROM END

SUBDIVISION ~~JAMES L. STUTTS~~ BLOCK / SECTION LOT 2 LOT AREA 0.57 ACRE SITE CLASS PS DESIGN FLOW 360 L.T.A.R. 0.25 gpd/ft²

STUTTS VIEW

Septic Tank: 1000 Gallons; STB 821 Date 11/19/04
Pump Tank: 1000 Gallons; PT 313 Date 2-25-03
Pump Make: Zoeller Model #N137-C Serial No.
Nitrification Field: No Fields 1 Square Feet EQ TO 1440 Linear Feet 240
No Lines FOUR Trench Width 24" Max Trench Bottom Depth 36" ~~Gravel~~ Depth SAND 24"

☑ New System ☐ Repair System Type: I, II, III, (IV), V, VI
System Description: 50% REDUCTION, LOW-PRESSURE
Repair System Description: 50% REDUCTION, LOW-PRESSURE
Maintenance Agreement Required: ☑ Yes ☐ No
☐ Slab ☑ Crawl Space ☐ Basement w/plumbing ☐ Basement wo/plumbing


☑ House/Mod. Home No. Bedrooms 3
☐ Mobile Home No. Bathrooms
☐ Business No. Employees
☐ Other

Water Supply: ☑ Individual ☐ Public ☐ Community
WELL


Comments/Conditions: ① EXISTING WELL TO BE ABANDONED PRIOR TO ISSUE OF AUTH TO CONST. ② INSTALL 50% REDUCTION SYSTEM USING 55 PPBPS PANELS USING LOW-PRESSURE DISTRIBUTION ③ SEE ATTACHED SHEETS FOR PUMP AND LOW-PRESSURE REQUIREMENTS

Comments/Conditions: ④ A CONTRACT SHALL BE EXECUTED BETWEEN SYSTEM OWNER & A MANAGEMENT ENTITY PRIOR TO ISSUANCE OF O.P.

INITIAL SITE SKETCH

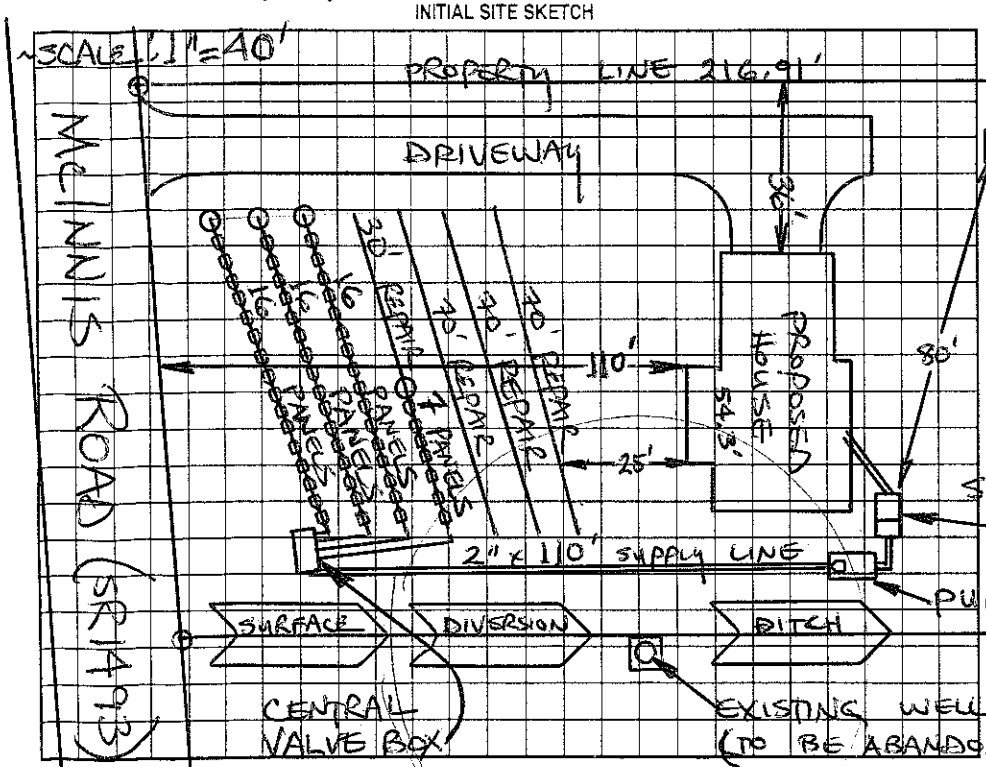

AS BUILT SKETCH

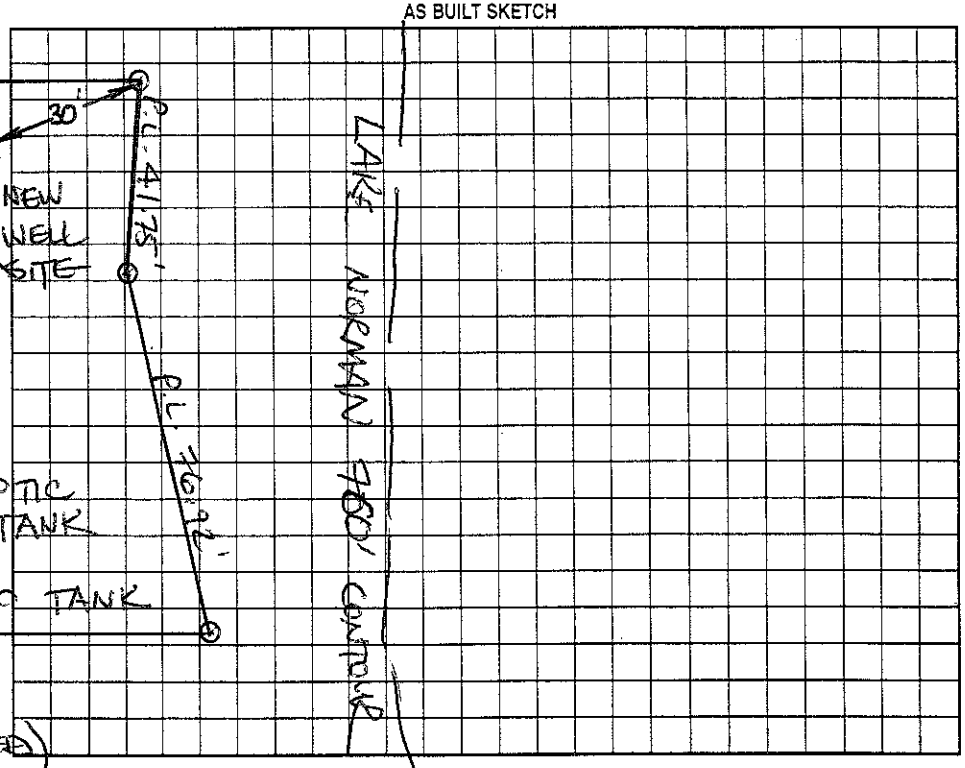

Permit can be suspended or revoked if any false information is supplied toward securing the permit/any unauthorized changes are made to the site/any unauthorized changes are made in the installation of the system. Improvement Permit with plat valid without expiration. Improvement Permit with site plan valid for sixty months. Authorization to Construct is valid for a period equal to that of Improvement Permit – not to exceed sixty months.

Signed: Duane Laudlaw date 8-3-04 Installed by: G+M Enterprises

Improvement Permit by: STEVE HEDRICK date 7-28-04 Operation Permit by: RS date 2/24/05

Authorization to Construct by: RS date 8/4/04 Existing System Inspection by: date

HEALTH DEPT. COPY: WHITE OWNER COPY (FINAL): YELLOW OWNER COPY (INITIAL): PINK

