IREDELL COUNTY HEALTH DEPARTMENT

STATESVILLE 704-878-5305 MOORESVILLE 704-664-5281

IMPROVEMENT PERMIT / AUTHORIZATION TO CONSTRUCT / OPERATION PERMIT / EXISTING SYSTEM INSPECTION

375.00 Paid

PERMIT# 122324 PIN# 4648-21-5716 DATE 7-28-04

OWNER OR CONTRACTOR BO OF NORTH CAROLINA INC PHONE: Business 704-696-2662 Home

ADDRESS 249 WILLIAMSON ROAD, SUITE 101, MOORESVILLE, NC 28117

LOCATION INC I-SD WEST TR BLUEFIELD RD, TL BIG INDIAN LOOP, TL MINNIS RD, LOT AT END ON RIGHT

SUBDIVISION ~~JAMES L. STUTTS~~ BLOCK / SECTION LOT 1 LOT AREA 0.57 ACRE SITE CLASS. PS DESIGN FLOW 480 L.T.A.R. 0.30 GPD/FT2

STUTTS VIEW

Septic Tank: 1000 Gallons; STB T85 Date 9/24/04

Pump Tank: 1000 Gallons; PT 313 Date 3/31/03

Pump Make: ZOELLER Model N-137 Serial No. 11/04

Nitrification Field: No Fields 1 Square Feet EQ. TO 1600 Linear Feet 270

No Lines FOUR Trench Width 24" Max Trench Bottom Depth 36" ~~Gravel~~ Depth SAND 24"

☑ New System ☐ Repair System Type: I, II, III, (IV), V, VI

System Description: 50% REDUCTION, LOW-PRESSURE

Repair System Description: 50% REDUCTION, LOW-PRESS

Maintenance Agreement Required: ☑ Yes ☐ No

☑ House/Mod. Home ☐ Mobile Home ☐ Business ☐ Other


No. Bedrooms 4 No. Bathrooms ___ No. Employees ___

☐ Slab ☑ Crawl Space ☐ Basement w/plumbing ☐ Basement wo/plumbing


Water Supply: ☑ Individual ☐ Public ☐ Community WELL

Comments/Conditions: ① INSTALL 50% REDUCTION SYSTEM USING 64 PPPS PANELS USING LOW-PRESSURE DISTRIBUTION ② SEE ATTACHED SHEETS FOR PUMP & LOW PRESSURE REQUIREMENTS ③ A CONTRACT SHALL BE EXECUTED BETWEEN SYSTEM OWNER AND A MANAGEMENT ENTITY PRIOR TO ISSUANCE OF O.P

INITIAL SITE SKETCH

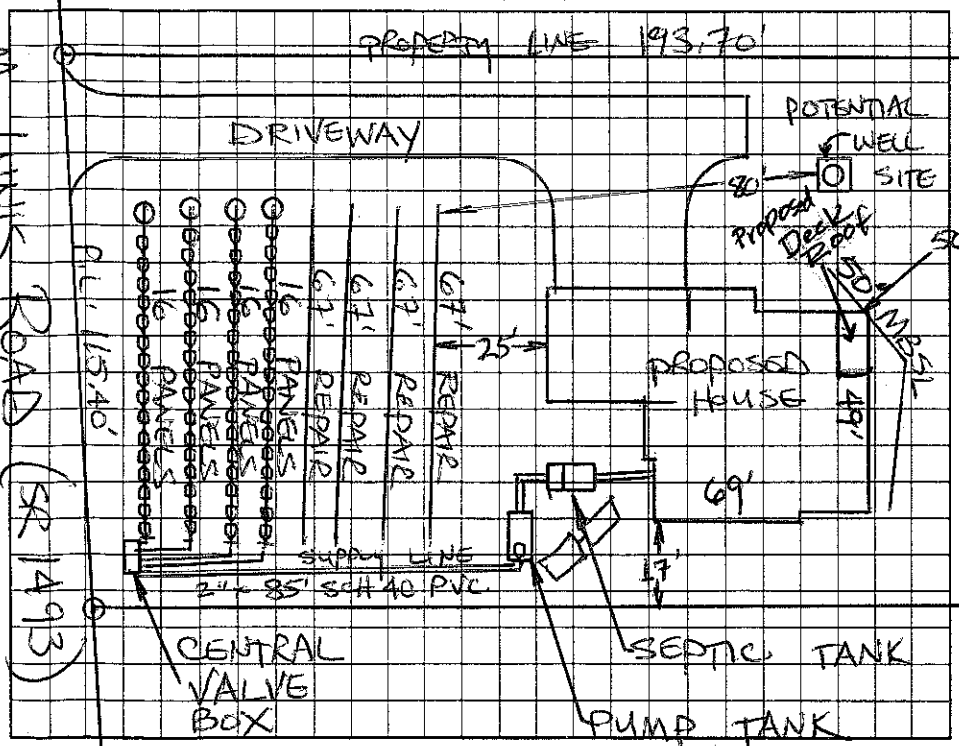

AS BUILT SKETCH

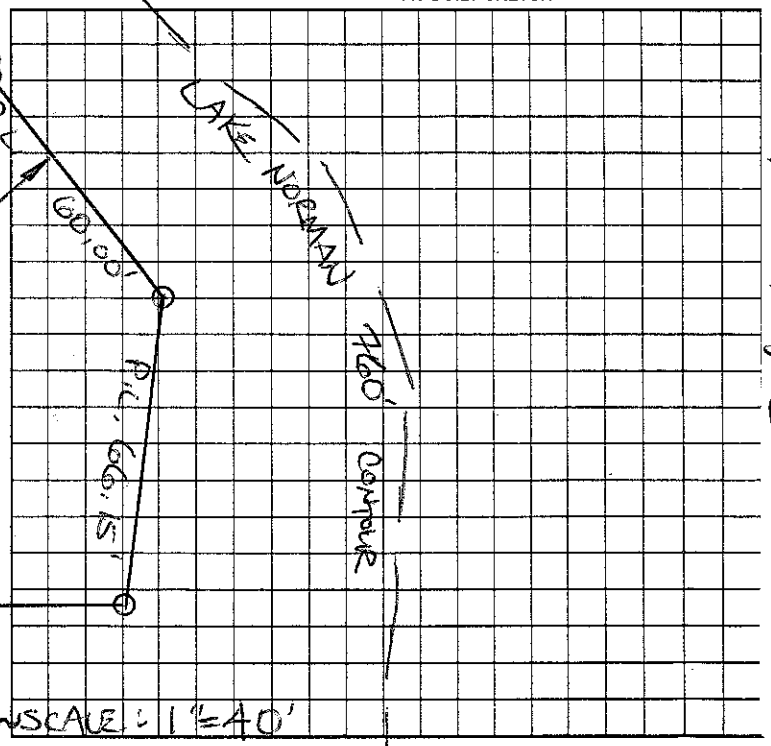

The proposed / existing Roof over deck addition does not appear to impact the existing septic system.

**NOTE: Audrey Mehaffie R.S.

Date: 9-16-2013

ICHD-Environmental Health Division

Permit can be suspended or revoked if any false information is supplied toward securing the permit/any unauthorized changes are made to the site/any unauthorized changes are made in the installation of the system. Improvement Permit with plat valid without expiration. Improvement Permit with site plan valid for sixty months. Authorization to Construct is valid for a period equal to that of Improvement Permit – not to exceed sixty months.

Signed: Duane Laidlaw date 8-3-04 Installed by: D&M Enterprises

Improvement Permit by: STEVE HEDRICK date 7-28-04 Operation Permit by: Wesley Sparkes date 11-12-05

Authorization to Construct by: STEVE HEDRICK date 7-28-04 Existing System Inspection by: ___ date ___

HEALTH DEPT. COPY: WHITE OWNER COPY (FINAL): YELLOW OWNER COPY (INITIAL): PINK