IREDELL COUNTY HEALTH DEPARTMENT

STATESVILLE 704-878-5305 MOORESVILLE 704-664-5281

IMPROVEMENT PERMIT / CERTIFICATE OF COMPLETION / OPERATION PERMIT / EXISTING SYSTEM INSPECTION

PROPERTY DESCRIPTION NO. 20296 DATE 2/22/95 TAX MAP NO. 2L 8A 14/4648-21-8741 Watershed: ☐ Yes ☒ No

OWNER OR CONTRACTOR Kimberly and Robert Hall PHONE: Business _____ Home 663-7236

ADDRESS PO Box 128 Statesville, NC. 28677

LOCATION Beech Tree Rd., on (L) past Springfield Subdivision

SUBDIVISION Beech Tree Estates BLOCK / SECTION _____ LOT 14 LOT AREA 2Ac SITE CLASS. P DESIGN FLOW 360 L.T.A.R. .3

Septic Tank: 1000 Gallons; STB 825 Date 9/7/95

Pump Tank: _____ Gallons; PT _____ Date _____

Pump Make: _____ Model _____ Serial No. _____

Nitrification Field: No Fields 1 Square Feet 1200 Linear Feet ~~200~~

No Lines 3 Trench Width 24 Max Trench Bottom Depth 36" Gravel Depth 12"

☒ New System ☐ Repair System Type: I, II, III, IV, V, VI

System Description: PPBS 16" - GRAVITY

Repair System Description: SAME

Maintenance Agreement Required: ☐ Yes ☒ No

☒ House/Mod. Home No. Bedrooms 3

☐ Mobile Home No. Bathrooms 2

☐ Business No. Employees _____

☐ Other _____


☐ Slab ☒ Crawl Space ☐ Basement w/plumbing ☐ Basement wo/plumbing

Water Supply: ☒ Individual ☐ Community ☐ Public

Comments: Keep trenches on contour in direction shown. Repair area must be clear of any trees. Plumbing must come out front of house.

Comments: Installed as drawn.

INITIAL SITE SKETCH

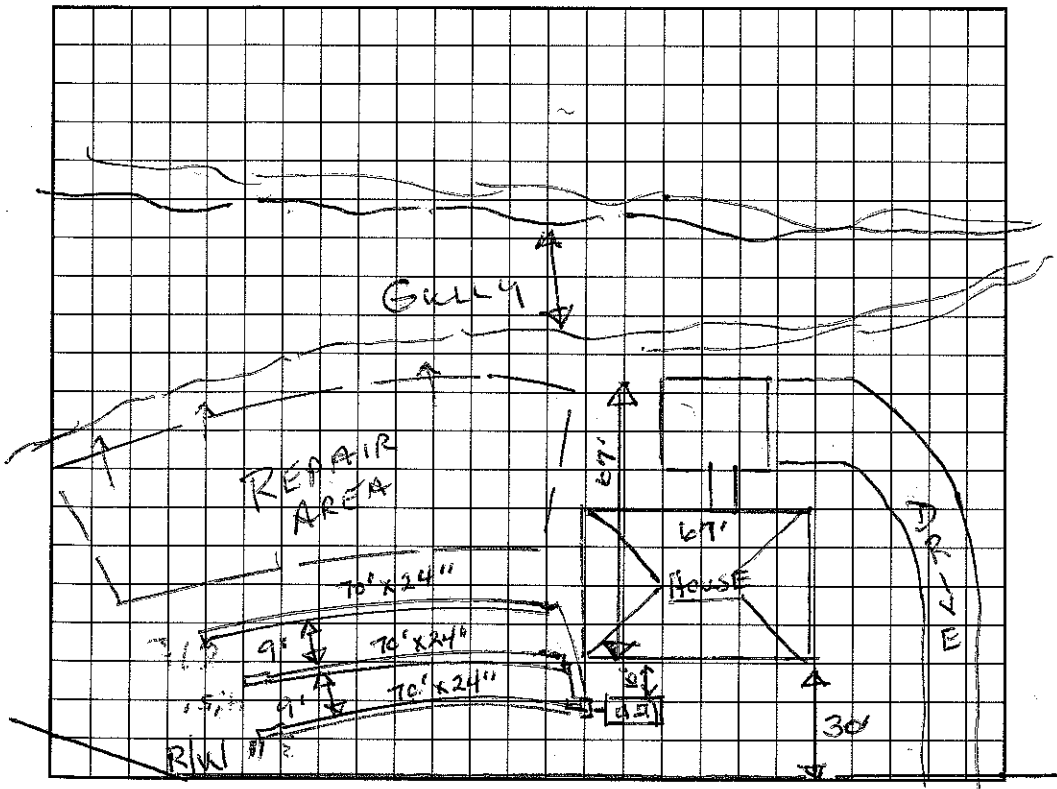

AS BUILT SKETCH

I understand that this permit can be suspended or revoked if any false information is supplied toward securing the permit/any unauthorized changes are made to the site/any unauthorized changes are made in the installation of the system. Improvement Permit is valid for 60 months from date of issuance.

Signed: Kimberly B. Hall

Improvement Permit by: Wesley Sparks R.S. date 2/22/95

Existing System Inspection by: _____ date _____

Installed by: Wayne Clontz.

Certificate of Completion by: _____ date _____

Operation Permit by: Wesley Sparks R.S. date 12/12/95

HEALTH DEPT. COPY: WHITE INSPECTION COPY (FINAL): GREEN OWNER COPY (FINAL): YELLOW INSPECTION COPY (INITIAL): PINK OWNER COPY (INITIAL): GOLD