4648223427

IREDELL COUNTY HEALTH DEPARTMENT

AUTHORIZATION TO CONSTRUCT

STATESVILLE 704-878-5305 MOORESVILLE 704-664-5281

IMPROVEMENT PERMIT / ~~CERTIFICATE OF COMPLETION~~ / OPERATION PERMIT / EXISTING SYSTEM INSPECTIO

PROPERTY DESCRIPTION NO. 25516 DATE 12/13/96 TAX MAP NO. 2P-B-21 pt of Watershed: ☑ Yes ☐ No

OWNER OR CONTRACTOR GERALD & PAM NANCE PHONE: Business _____ Home 881-2326

ADDRESS 350 BIG INDIAN MOORESVILLE

LOCATION 150 W-TR BLUEFIELD - TL BIG INDIAN - ON LEFT PAST CHEROKEE DR.

SUBDIVISION THE SPUTS BLOCK / SECTION — LOT 5 LOT AREA ± 2 AC SITE CLASS. RS DESIGN FLOW 360 GPD L.T.A.R. .30 TP/FP2

Septic Tank: 1000 Gallons; STB 794 Date 10/18/97

Pump Tank: _____ Gallons; PT _____ Date _____

Pump Make: _____ Model _____ Serial No. _____

Nitrification Field: No Fields 1 Square Feet 1200 Linear Feet 400

No Lines 5 Trench Width 36" Max Trench Bottom Depth 24" Gravel Depth 12"

☑ New System ☐ Repair System Type: I, II, III, IV, V, VI

System Description: GRAVITY CONVENTIONAL

Repair System Description: SAME

Maintenance Agreement Required: ☐ Yes ☑ No

☑ House/Mod. Home No. Bedrooms 3

☐ Mobile Home No. Bathrooms 2

☐ Business No. Employees ____

☐ Other _____


☐ Slab ☑ Crawl Space ☐ Basement w/plumbing ☐ Basement wo/plumbing

Water Supply: ☑ Individual ☐ Community ☐ Public

Comments: TERRACE IS TO BE REMOVED

Comments: installed as shown on Auth Const

INITIAL SITE SKETCH NOT TO SCALE

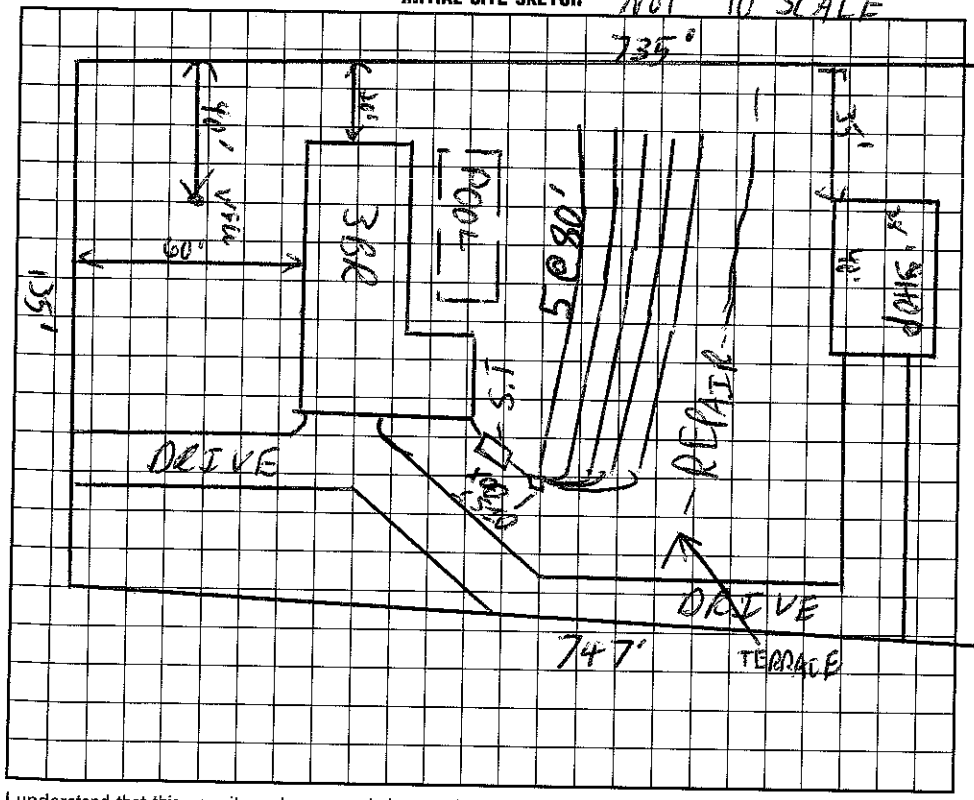

AS BUILT SKETCH

I understand that this permit can be suspended or revoked if any false information is supplied toward securing the permit/any unauthorized changes are made to the site/any unauthorized changes are made in the installation of the system.

Signed: Gerald Nance

Improvement Permit by: C. Blythe EHS date 12/13/96

~~Existing System Inspection~~ AUTHORIZATION by: C. Blythe EHS date 12/13/96

CONSTRUCT

Installed by: FJ Ervin

Certificate of Completion by: Wesley Sparks RS date 11/20/97

Operation Permit by: Wesley Sparks RS. date 11/24/97

HEALTH DEPT. COPY: WHITE INSPECTION COPY (FINAL): GREEN OWNER COPY (FINAL): YELLOW INSPECTION COPY (INITIAL): PINK OWNER COPY (INITIAL): GOLD