IREDELL COUNTY HEALTH DEPARTMENT

STATESVILLE 704-878-5305 MOORESVILLE 704-664-5281

IMPROVEMENT PERMIT / AUTHORIZATION TO CONSTRUCT / OPERATION PERMIT / EXISTING SYSTEM INSPECTION

PERMIT# 072338 PIN# 4648229730 DATE 3/25/98

OWNER OR CONTRACTOR Alex & Sherrie White PHONE: Business 451-8027 Mobile Home 663-4707 / Sherrie 664-7494

ADDRESS 120 Preston Rd. Mooresville NC 28115

LOCATION Hwy 150 TR Bluefield Rd TL Big Indian Loop ~ 1 mile on left at Powerline

SUBDIVISION ____ BLOCK / SECTION ____ LOT 24 LOT AREA 1.67 Acre SITE CLASS. PS DESIGN FLOW 360 gpd L.T.A.R. .3 - .34

Septic Tank: 1000 Gallons; STB ____ Date 12/7/98
Pump Tank: ____ Gallons; PT ____ Date ____
Pump Make: ____ Model ____ Serial No. ____
Nitrification Field: No Fields 1 Square Feet 1200 Linear Feet 400
No Lines 5 at 80' Trench Width 36" Max Trench Bottom Depth 36" Gravel Depth 12"

☐ New System ☐ Repair System Type: I, (II), III, IV, V, VI
System Description: Gravity - Conventional
Repair System Description: Same
Maintenance Agreement Required: ☐ Yes ☒ No

☒ House/Mod. Home No. Bedrooms 3
☐ Mobile Home No. Bathrooms 2
☐ Business No. Employees ____
☐ Other ____

☐ Slab ☐ Crawl Space ☒ Basement w/plumbing ☐ Basement wo/plumbing


Water Supply: ☒ Individual ☐ Public ☐ Community

Comments:/Conditions: Keep Septic System at least 10' from PL & 25' from Up gradient Side of Basement & 100' from well. * Owner will have basement plumbing "roughed in" & wants to use grinder pump to get Sewage to Tank


Comments:/Conditions: will use grinder pump

INITIAL SITE SKETCH

Scale 1:50

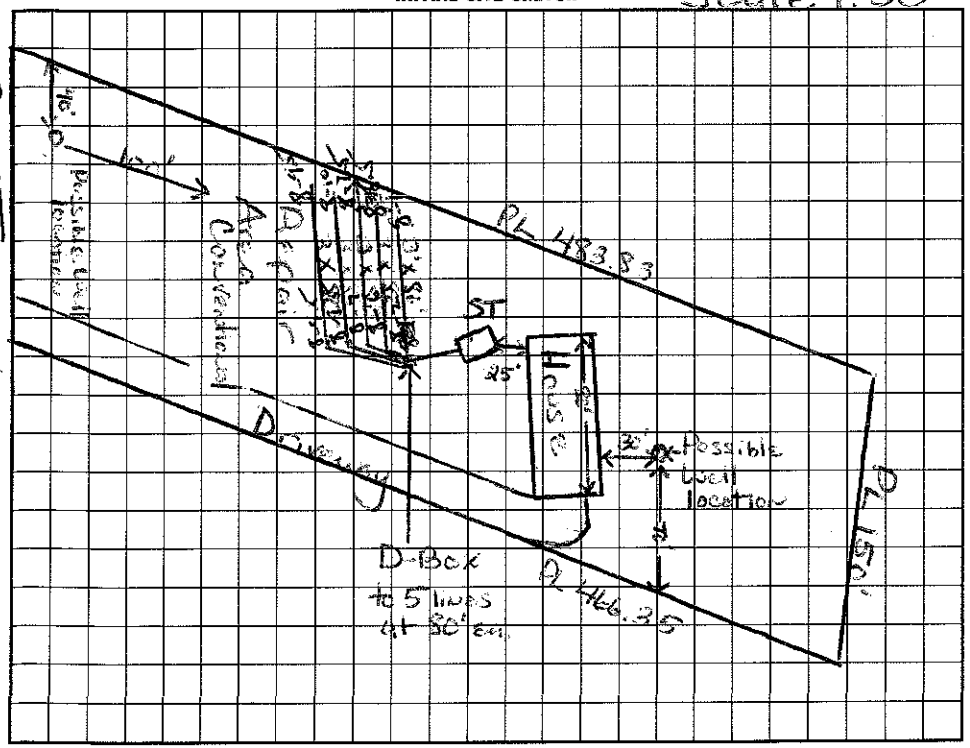

AS BUILT SKETCH

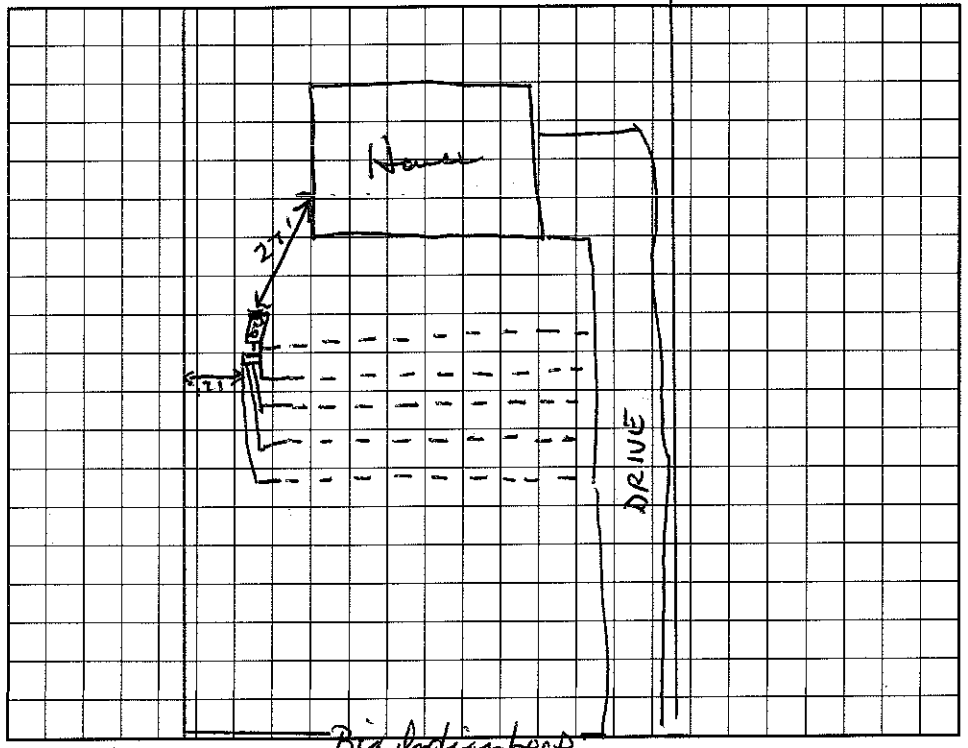

I understand that this permit can be suspended or revoked if any false information is supplied toward securing the permit/any unauthorized changes are made to the site/any unauthorized changes are made in the installation of the system. Improvement Permit with plat valid without expiration. Improvement Permit with site plan valid for sixty months. Authorization to Construct is valid for a period equal to that of Improvement Permit – not to exceed sixty months.

Signed: Alex White date ____ Installed by: FJ Ervin

Improvement Permit by: Maria H. Dotson date 3/25/98 Operation Permit by: Wesley Sparks R.S. date 1/29/99

Authorization to Construct by: Maria H. Dotson date 3/25/98 Existing System Inspection by: ____ date ____

HEALTH DEPT. COPY: WHITE INSPECTION COPY (FINAL): GREEN OWNER COPY (FINAL): YELLOW INSPECTION COPY (INITIAL): PINK OWNER COPY (INITIAL): GOLD