IREDELL COUNTY HEALTH DEPARTMENT

TESVILLE 704-878-5305 MOORESVILLE 704-664-5281

IMPROVEMENT PERMIT / AUTHORIZATION TO CONSTRUCT / OPERATION PERMIT / EXISTING SYSTEM INSPECTION

PERMIT# 079404 PIN# 4648 22 5235 DATE 3/1/99

OWNER OR CONTRACTOR Roger Neill PHONE: Business Home 663-0425

ADDRESS 451 Wiggins Rd. Mooresville, NC. 28115

LOCATION Big Iredell loop, straight TL McInnis, on (L) at cul de sac

SUBDIVISION Joe R Stutts BLOCK / SECTION LOT 1 LOT AREA 1.97 AC SITE CLASS. PS DESIGN FLOW 480 L.T.A.R. .3

Septic Tank 1000 Gallons; STB Short Date 4/11/99

Pump Tank: Gallons; PT Date

Pump Make: Model Serial No.

Nitrification Field: No Fields 1 Square Feet 1200* Linear Feet 400 *

No Lines 4@57'x3' Trench Width 36" Max Trench Bottom Depth 32" Gravel Depth SAND.

[X] New System [ ] Repair System Type: I, II, (III) IV, V, VI

System Description: *25% Reduction-CH. PLASTIC

Repair System Description: Pressure to 16" PPRS

Maintenance Agreement Required: [ ] Yes [X] No

[X] House/Mod. Home No. Bedrooms 4

[ ] Mobile Home No. Bathrooms 3

[ ] Business No. Employees

[ ] Other


[ ] Slab [ ] Crawl Space [ ] Basement w/plumbing [X] Basement wo/plumbing

Water Supply: [X] Individual [ ] Public [ ] Community

Comments:/Conditions: * Reduction figured - install whats shown on this permit.


Comments:/Conditions: 5 Lines Drop Boxes

INITIAL SITE SKETCH

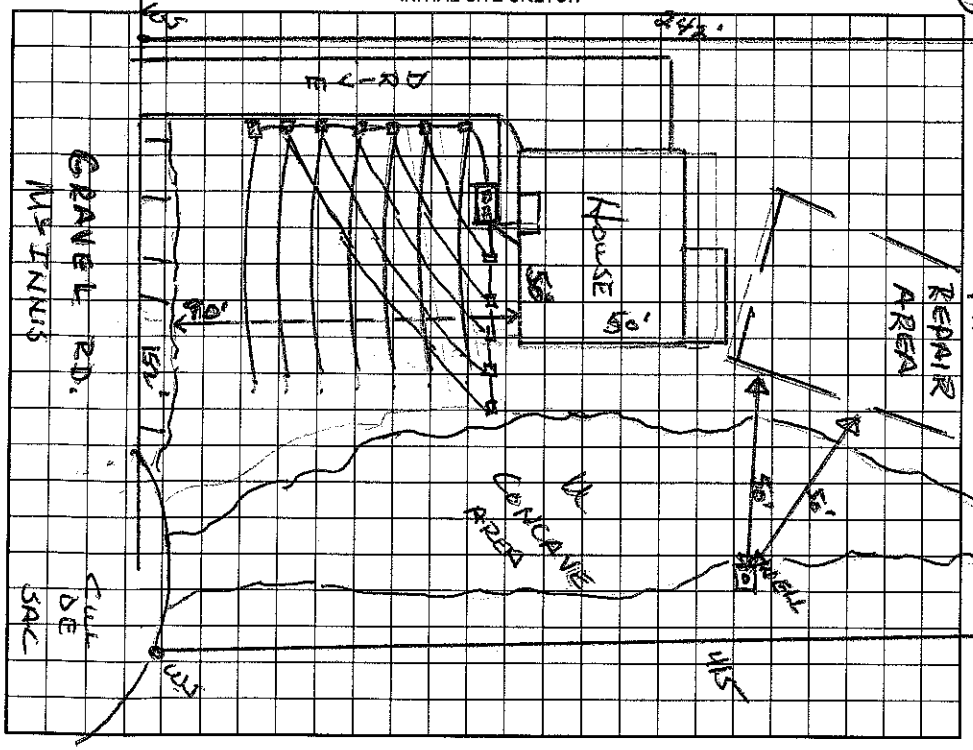

1" = 50'

AS BUILT SKETCH

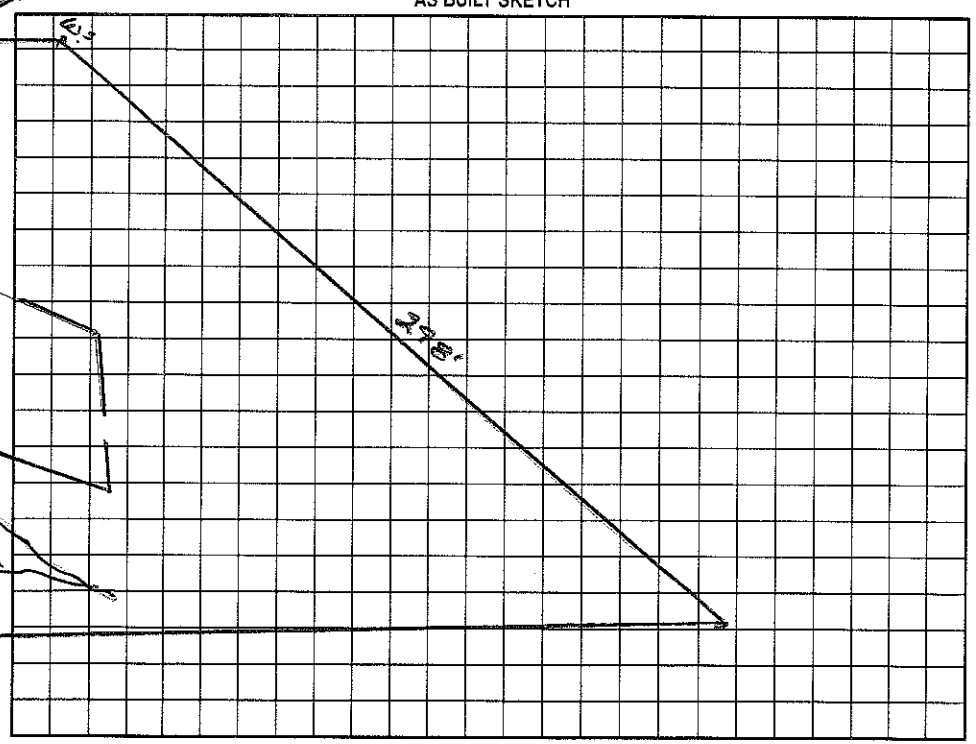

Permit can be suspended or revoked if any false information is supplied toward securing the permit/any unauthorized changes are made to the site/any unauthorized changes are made in the installation of the system. Improvement Permit with plat valid without expiration. Improvement Permit with site plan valid for sixty months. Authorization to Construct is valid for a period equal to that of Improvement Permit – not to exceed sixty months.

Signed: * Roger D. Neill date

Improvement Permit by: Wesley Sparks RS. date 3/1/99

Authorization to Construct by: Wesley Sparks RS date 3/1/99

Installed by: Benny Myers

Operation Permit by: Wesley Sparks RS. date 6/1/99

Existing System Inspection by: date

HEALTH DEPT. COPY: WHITE OWNER COPY (FINAL): YELLOW OWNER COPY (INITIAL): PINK