IREDELL COUNTY HEALTH DEPARTMENT

STATESVILLE 704-878-5305 MOORESVILLE 704-664-5281

4648 22 7667

IMPROVEMENT PERMIT / CERTIFICATE OF COMPLETION / OPERATION PERMIT / EXISTING SYSTEM INSPECTION

PROPERTY DESCRIPTION NO. 19969 DATE 1/6/95 TAX MAP NO. 2P-B-21

OWNER OR CONTRACTOR Aubrey Poole PHONE: Business Watershed: ☐ Yes ☒ No

ADDRESS 289 Big Indian Loop Mooresville, NC 28115 Home 664-4815

LOCATION Big Indian off Blue Ridge on (L) just past 289 to end of drive

SUBDIVISION N/A BLOCK / SECTION LOT LOT AREA ~2AC SITE CLASS. P DESIGN FLOW 360 L.T.A.R. .3-.35

Septic Tank: 1600 Gallons; STB 521 Date 3-2-95

Pump Tank: Gallons; PT Date

Pump Make: Model Serial No.

Nitrification Field: No Fields 1 Square Feet 1200 Linear Feet 400

No Lines 4/5 Trench Width 1 36" Max Trench Bottom Depth 36" Gravel Depth 12"

☒ New System ☐ Repair System Type: I (II) III, IV, V, VI

System Description: CONV-DROP BOX

Repair System Description: PANEL

Maintenance Agreement Required: ☐ Yes ☒ No

☐ House/Mod. Home ☒ Mobile Home ☐ Business ☐ Other

No. Bedrooms 3 No. Bathrooms 2.5 No. Employees


☐ Slab ☒ Crawl Space ☐ Basement w/plumbing ☐ Basement wo/plumbing

Water Supply: ☒ Individual ☐ Community ☐ Public

Comments:

Comments: Home and well not located at time of inspection. Keep both required distances from septic system.

INITIAL SITE SKETCH

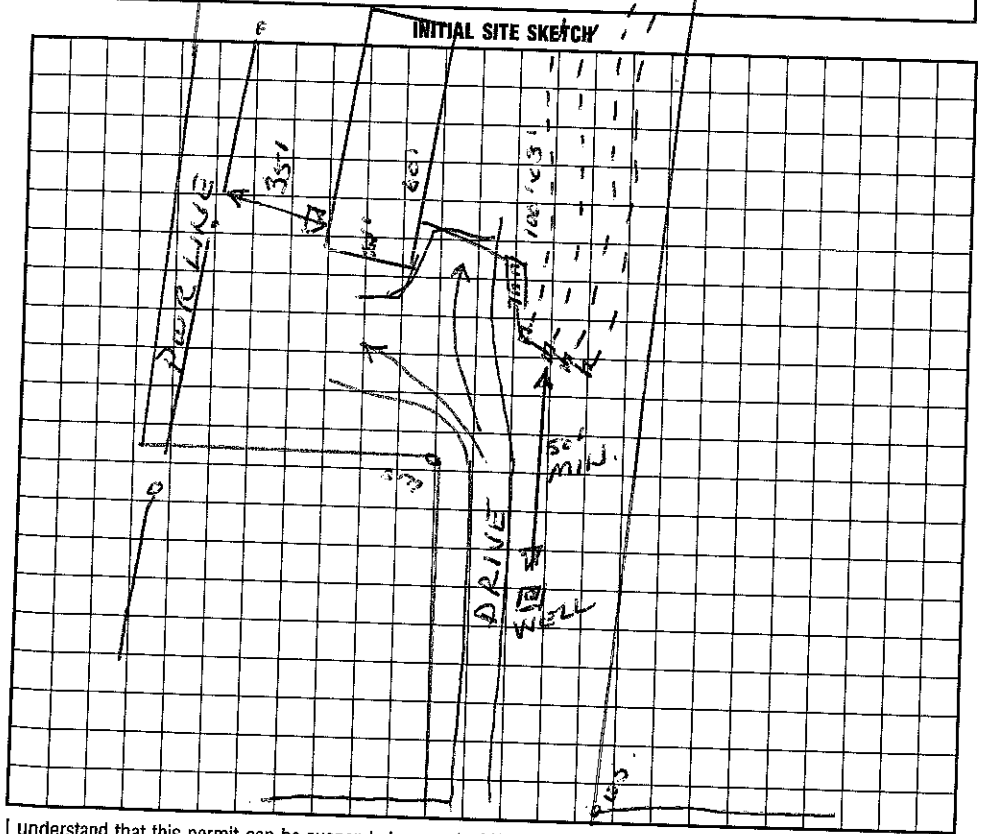

AS BUILT SKETCH

SAME AS INITIAL SKETCH

I understand that this permit can be suspended or revoked if any false information is supplied toward securing the permit/any unauthorized changes are made to the site/any unauthorized changes are made in the installation of the system. Improvement Permit is valid for 60 months from date of issuance. BIG INDIAN LOOP

Signed: Aubrey Dodd Poole

Improvement Permit by: Wesley Sparks RS. date 1/6/95

Existing System Inspection by: date

Installed by: G & M Enterprises

Certificate of Completion by: Michael G. Owens date 4-5-95

Operation Permit by: date

HEALTH DEPT. COPY: WHITE INSPECTION COPY (FINAL): GREEN OWNER COPY (FINAL): YELLOW INSPECTION COPY (INITIAL): PINK OWNER COPY (INITIAL): GOLD