IREDELL COUNTY HEALTH DEPARTMENT

STATESVILLE 704-878-5305 MOORESVILLE 704-664-5281

IMPROVEMENT PERMIT / AUTHORIZATION TO CONSTRUCT / OPERATION PERMIT / EXISTING SYSTEM INSPECTION

PERMIT# 146678 PIN# 4648229150 DATE 12-3-07

OWNER OR APPLICANT Ranger Enterprises PHONE: Business 704-202-5473 Home

ADDRESS 310 Country Ridge Rd Rockwell NC 28138

LOCATION 21 N TL Cornelius Rd TL Bluefield TR Big Indian Loop take left Loop TL Cherokee

SUBDIVISION Bearfoot Bay BLOCK / SECTION LOT 12 LOT AREA .7 Ac SITE CLASS. DESIGN FLOW 360gpd L.T.A.R.

Septic Tank: Existing Gallons: STB Date

Pump Tank: Gallons: PT Date

Pump Make: Model Serial No.

Nitrification Field: No Fields Square Feet Linear Feet

No Lines Trench Width Max Trench Bottom Depth Gravel Depth ☒ Gravity ☐ Pressure

☐ New System ☐ Repair ☐ Expansion System Type: ☒ I ☐ II ☐ III ☐ IV ☐ V ☐ VI

System Description: conventional gravity

Repair System Description: 25% reduction

Maintenance Agreement Required: ☐ Yes ☒ No

☒ House/Mod. Home No. Bedrooms 3

☐ Mobile Home No. Persons 6

☐ Business No. Employees

☐ Other


Water Supply: ☒ Individual ☐ Public ☐ Community

☐ Slab ☒ Crawl Space ☐ Basement w/plumbing ☐ Basement wo/plumbing

Comments:/Conditions:


Comments:/Conditions: House addition with no additional bedrooms
See Existing Permit #25338 8-1-97

INITIAL SITE SKETCH

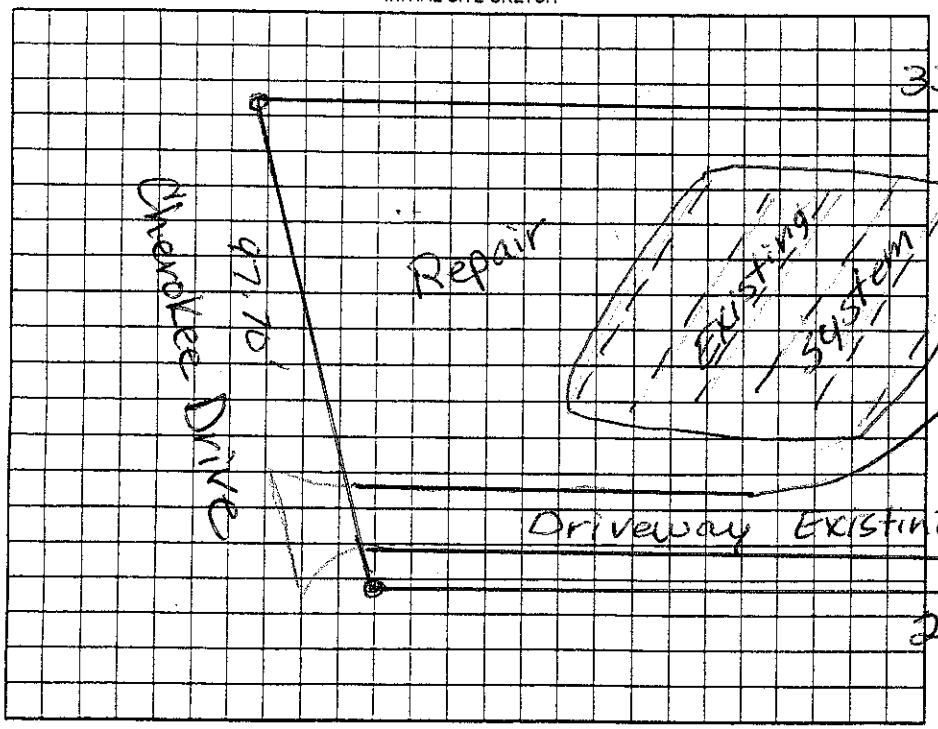

1" = 40'

AS BUILT SKETCH

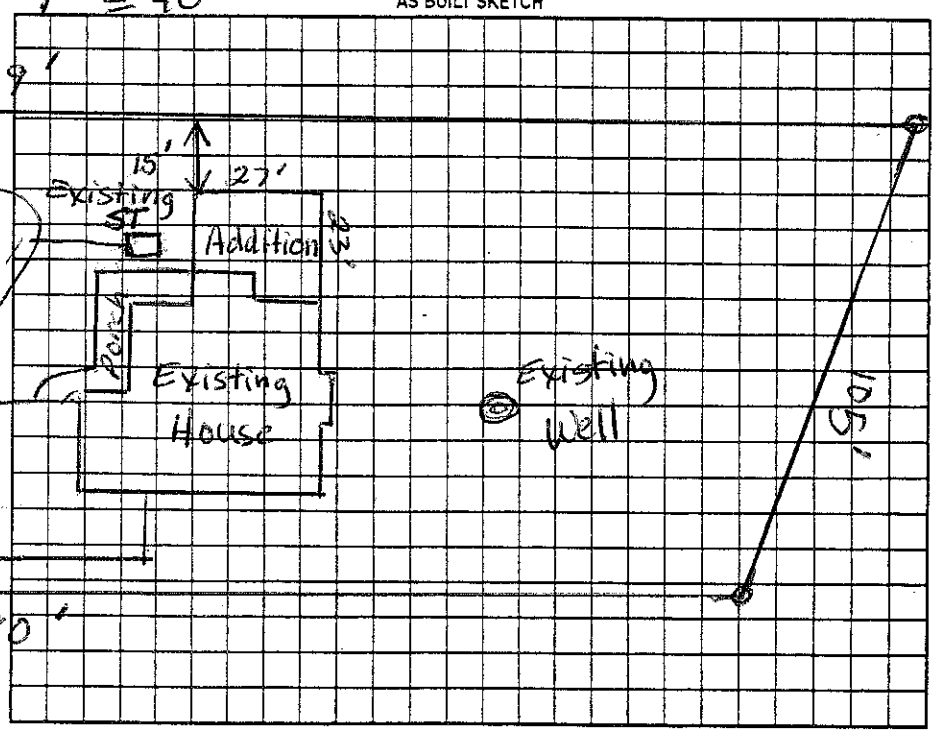

Permit can be suspended or revoked if any false information is supplied toward securing the permit/any unauthorized changes are made to the site/any unauthorized changes are made in the installation of the system. Improvement Permit with plat valid without expiration ☐ Improvement Permit with site plan valid for sixty months ☐ Authorization to Construct is valid for a period equal to that of Improvement Permit – not to exceed sixty months.

Signed: date 12-4-07 Installed by:

Improvement Permit by: date Operation Permit by: date

Authorization to Construct by: date Existing System Inspection by: Judy Melville date

HEALTH DEPT. COPY: WHITE OWNER COPY (FINAL): YELLOW OWNER COPY (INITIAL): PINK