IREDELL COUNTY HEALTH DEPARTMENT

STATESVILLE 704-878-5305 MOORESVILLE 704-664-5281

IMPROVEMENT PERMIT / CERTIFICATE OF COMPLETION / OPERATION PERMIT / EXISTING SYSTEM INSPECTION

PROPERTY DESCRIPTION NO. 25338 DATE 11/25/96 TAX MAP NO. 2P-10-A 12 4648-22-9150 Watershed: ☒ Yes ☐ No

OWNER OR CONTRACTOR Jackie L Johnson PHONE: Business _____ Home 599-4910

ADDRESS PO Box 1691 Statesville, NC 28687-1691

LOCATION Cherokee Dr. TR off Big Elm Dr. Loop, 1st lot on R before end of loop

SUBDIVISION Beaufort Bay BLOCK / SECTION _____ LOT 12 LOT AREA ~.8 AC SITE CLASS PS DESIGN FLOW 360 L.T.A.R. .35

Septic Tank: 1000 Gallons; STB 1017 Date 5/20/97

Pump Tank: _____ Gallons; PT _____ Date _____

Pump Make: _____ Model _____ Serial No. _____

Nitrification Field: No Fields 2 Square Feet 1028 Linear Feet 345

No Lines 6 (3+3) Trench Width 36" Max Trench Bottom Depth 36" Gravel Depth 12"

☒ New System ☐ Repair System Type: I, II, III, IV, V, VI

System Description: Conv.

Repair System Description: _____

Maintenance Agreement Required: ☐ Yes ☒ No

☒ House/Mod. Home No. Bedrooms 3

☐ Mobile Home No. Bathrooms 3

☐ Business No. Employees _____

☐ Other _____

☐ Slab ☒ Crawl Space ☐ Basement w/plumbing ☐ Basement wo/plumbing


Water Supply: ☒ Individual ☐ Community ☐ Public

Comments:


Some fill material found but no deeper than 20" to original material

Comments:

INITIAL SITE SKETCH

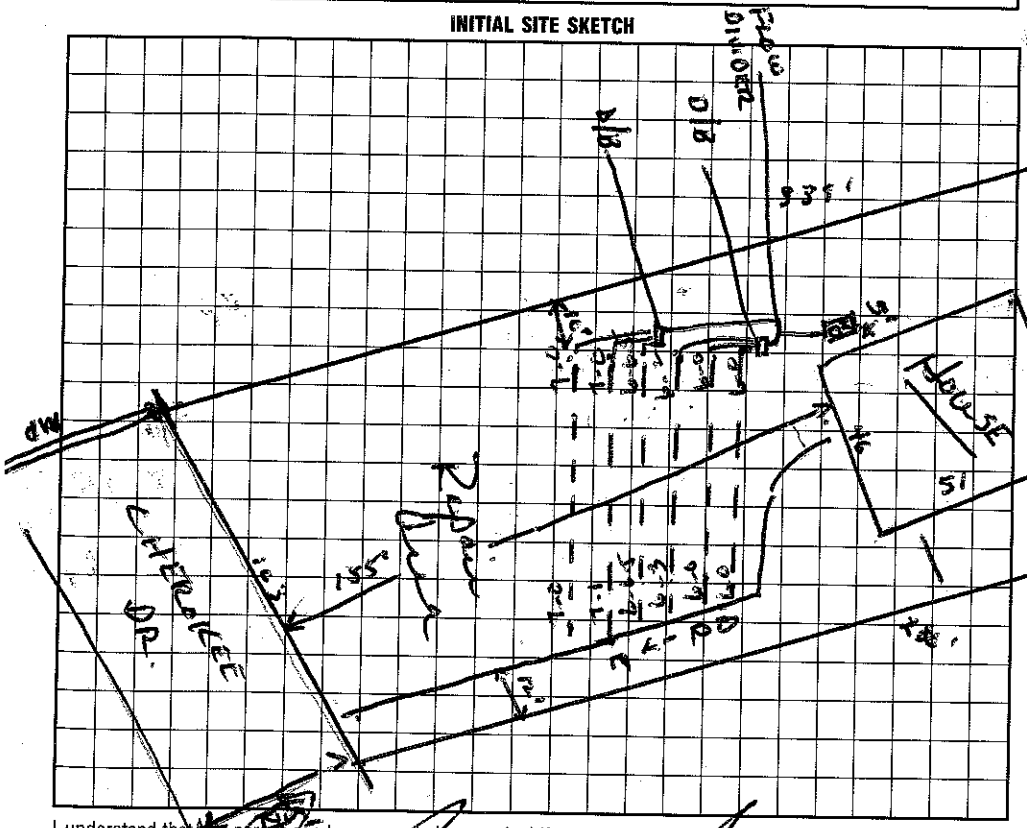

AS BUILT SKETCH

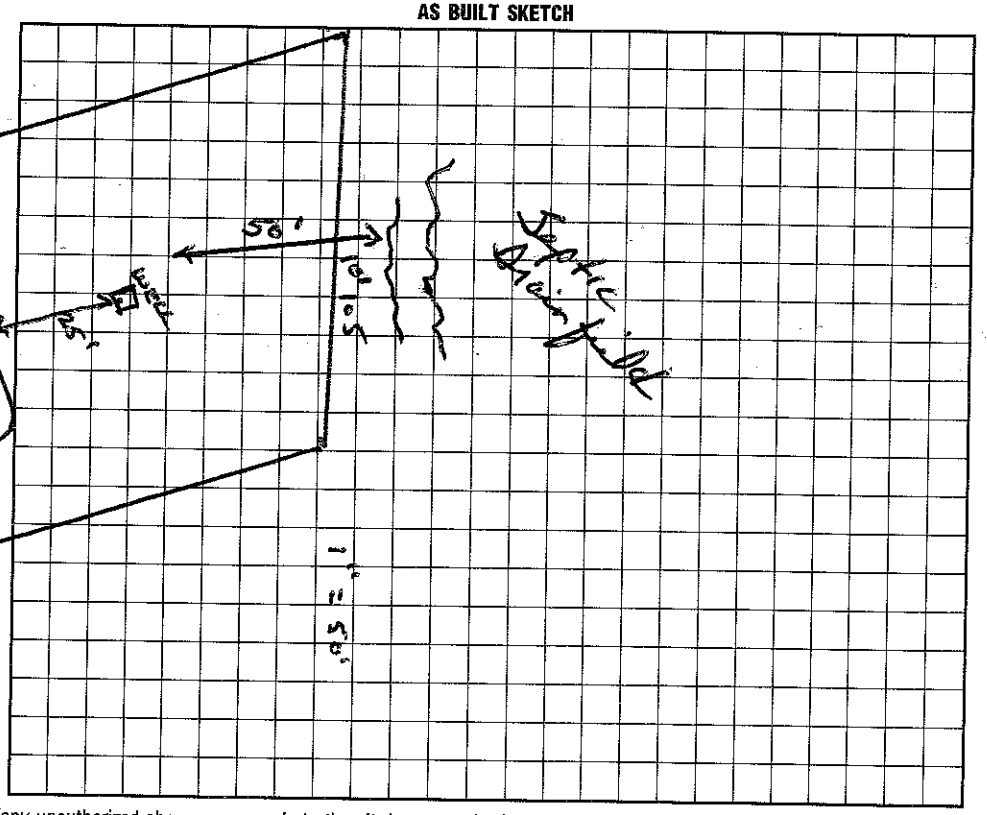

I understand that this permit can be suspended or revoked if any false information is supplied toward securing the permit/any unauthorized changes are made to the site/any unauthorized changes are made in the installation of the system.

Signed: [signature]

Improvement Permit by: Wesley Sparks R.S. date 11/25/96

Existing System Inspection by: Wesley Sparks R.S. date 11/25/96

Installed by: Yountz & Son Grading

Certificate of Completion by: Wesley Sparks R.S. date 8/1/97

Operation Permit by: Wesley Sparks R.S. date 8/1/97

HEALTH DEPT. COPY: WHITE INSPECTION COPY (FINAL): GREEN OWNER COPY (FINAL): YELLOW INSPECTION COPY (INITIAL): PINK OWNER COPY (INITIAL): GOLD