# IREDELL COUNTY HEALTH DEPARTMENT

STATESVILLE 704-878-5305 MOORESVILLE 704-664-5281

## IMPROVEMENT PERMIT / AUTHORIZATION TO CONSTRUCT / OPERATION PERMIT / EXISTING SYSTEM INSPECTION

130.00 Paid

PERMIT# 124864 PIN# 4648 23 0767 DATE 1/19/05

OWNER OR CONTRACTOR Mark A Romano PHONE: Business 704-995-3690 Home

ADDRESS 7800 Renaissance Ct. Charlotte NC 28721

LOCATION 150 W TR Bluefield Rd TL Big Indian Lp, straight to bitten (R) before Churchill Ln.

SUBDIVISION Indian Forest BLOCK / SECTION LOT 1 LOT AREA 1.04 ac SITE CLASS PS DESIGN FLOW 480 L.T.A.R. .3

Septic Tank: 1000 Gallons; STB 194 Date 4/1/06
Pump Tank: Gallons; PT Date
Pump Make: Model Serial No.
Nitrification Field: No Fields 1 Square Feet 530/795 Linear Feet 265
No Lines 5@53 Trench Width 2-3' Max Trench Bottom Depth 3'

[X] New System [ ] Repair System Type: I, II, [III], IV, V, VI
System Description: Dist Box → 16" PPBAS
Repair System Description: Pump Dosed 16" PPBAS
Maintenance Agreement Required: [ ] Yes [X] No

Gravel Depth N/A


[X] House/Mod. Home No. Bedrooms 4
[ ] Mobile Home No. Bathrooms 4
[ ] Business No. Employees
[ ] Other
[ ] Slab [ ] Crawl Space [X] Basement w/plumbing [ ] Basement wo/plumbing

Water Supply: [X] Individual [ ] Public [ ] Community

Comments:/Conditions:

1" = 50' 274


INITIAL SITE SKETCH

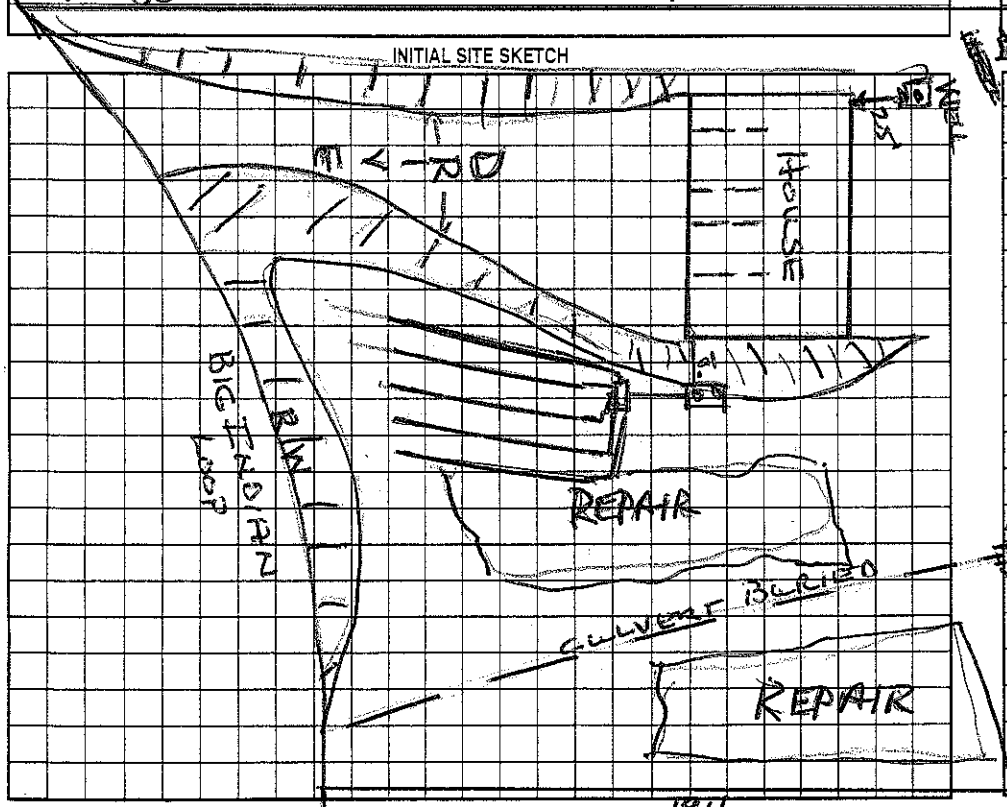


Comments:/Conditions:

53
12
106
53
52 CAB
12
106

AS BUILT SKETCH

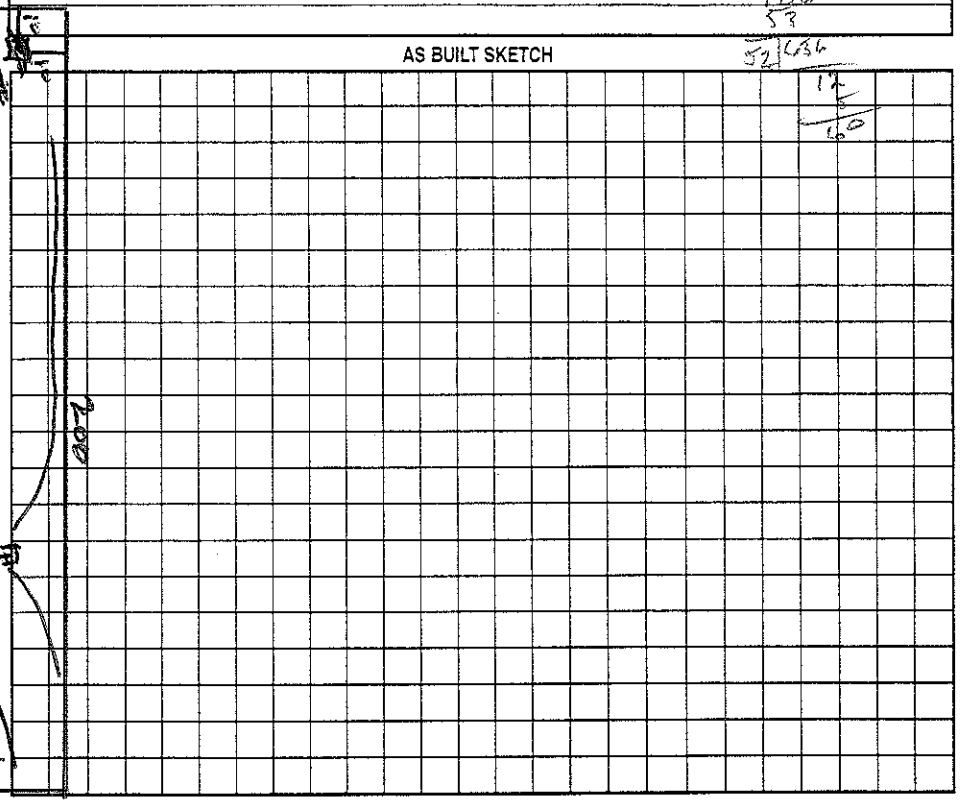

Permit can be suspended or revoked if any false information is supplied toward securing the permit/any unauthorized changes are made to the site/any unauthorized changes are made in the installation of the system. Improvement Permit with plat valid without expiration. Improvement Permit with site plan valid for sixty months. Authorization to Construct is valid for a period equal to that of Improvement Permit – not to exceed sixty months.

Signed: [X] date 1/20/05 Installed by: Perry Lanning

Improvement Permit by: Wesley Sparks RS. date 1/19/05 Operation Permit by: Wesley Sparks RS. date 10/4/06

Authorization to Construct by: Wesley Sparks RS date 1/19/05 Existing System Inspection by: date

HEALTH DEPT. COPY: WHITE OWNER COPY (FINAL): YELLOW OWNER COPY (INITIAL): PINK