1:00

IREDELL COUNTY HEALTH DEPARTMENT

STATESVILLE 704-878-5305 MOORESVILLE 704-664-5281

IMPROVEMENT PERMIT / AUTHORIZATION TO CONSTRUCT / OPERATION PERMIT / EXISTING SYSTEM INSPECTION

PERMIT# 108809 PIN# ~~4648235432~~ 4648232544 DATE 10-17-2002

OWNER OR CONTRACTOR Mike & Frances Cook PHONE: Business 704 507-0814 Home (704) 664-1410 Mike's Mom

ADDRESS 314 Big Indian Loop Mooresville, NC 28117

LOCATION Bluefield TL Big Indian Loop Stay straight towards Lake on right behind 314 Big Indian

SUBDIVISION — BLOCK / SECTION — LOT — LOT AREA 1.81 Acre SITE CLASS PS DESIGN FLOW 240gpd L.T.A.R. .3

Septic Tank: 1000 Gallons; STB 1007 Date 11-17-02
Pump Tank: — Gallons; PT — Date —
Pump Make: — Model — Serial No. —
Nitrification Field: No Fields 1 Square Feet 810' Linear Feet 270'
No Lines 3@90' Trench Width 36" Max Trench Bottom Depth 36" Gravel Depth 12"

☒ New System ☐ Repair System Type: I, II, III, IV, V, VI
System Description Gravity-Conventional
Repair System Description: Same
Maintenance Agreement Required: ☐ Yes ☒ No


☒ House/Mod. Home ☐ Mobile Home ☐ Business ☐ Other
No. Bedrooms 3 No. Bathrooms 1.5 No. Employees —
☐ Slab ☒ Crawl Space ☐ Basement w/plumbing ☐ Basement wo/plumbing

Water Supply: ☒ Individual ☐ Public ☐ Community


Comments/Conditions: Keep Septic System at least 10' from PL, 100' 50' from any well.

Comments/Conditions: Okay to "feather" out old farm berms.
Yellow filter inst

INITIAL SITE SKETCH Scale: 1:100'

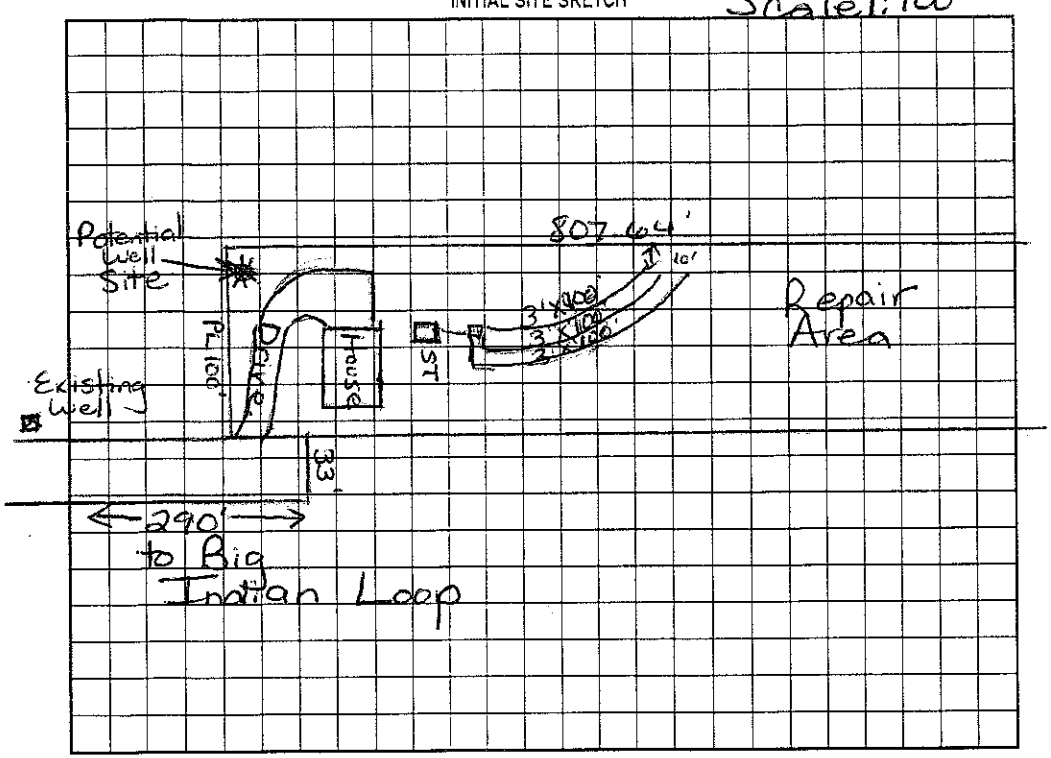

AS BUILT SKETCH

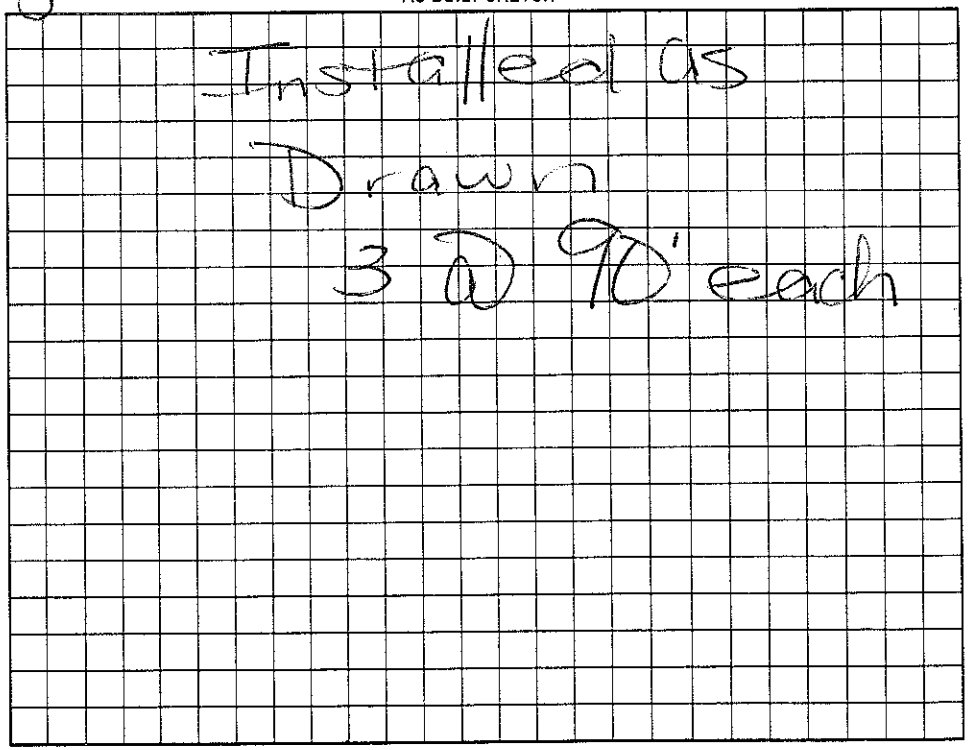

Permit can be suspended or revoked if any false information is supplied toward securing the permit/any unauthorized changes are made to the site/any unauthorized changes are made in the installation of the system. Improvement Permit with plat valid without expiration. Improvement Permit with site plan valid for sixty months. Authorization to Construct is valid for a period equal to that of Improvement Permit – not to exceed sixty months.

Signed: Frances Cook date —
Improvement Permit by: Maria H. Dolan RS date 10/17/02
Authorization to Construct by: Maria H. Dolan RS date 10/17/02

Installed by: Wayne Dentz
Operation Permit by: Maria H. Dolan RS date 1/15/03
Existing System Inspection by: — date —

HEALTH DEPT. COPY: WHITE OWNER COPY (FINAL): YELLOW OWNER COPY (INITIAL): PINK