IREDELL COUNTY HEALTH DEPARTMENT

STATESVILLE 704-878-5305 375.00 R.C.P. MOORESVILLE 704-664-5281

IMPROVEMENT PERMIT / AUTHORIZATION TO CONSTRUCT / OPERATION PERMIT / EXISTING SYSTEM INSPECTION

PERMIT# 129404 PIN# 4648 23 4329 DATE Sept. 16, 05

OWNER OR CONTRACTOR Ward Diversified Services / Greg Dimon PHONE: Business (704) 902-3907 Home

ADDRESS 8156 Monte Rd. Catawba, N.C. 28609

LOCATION 150W TR Bluefield Rd TL Big Indian Loop TR Palos Verde Dr. 4th lot on left

SUBDIVISION Palos Verde BLOCK / SECTION LOT 5 LOT AREA 26,229 ft² SITE CLASS PS DESIGN FLOW 480 gpd L.T.A.R. .2-.25

Septic Tank: 1000 Gallons; STB 794 Date 10/1/06

Pump Tank: 1000 Gallons; PT 283 Date 1/14/07

Pump Make: Model Serial No.

Nitrification Field: No Fields Square Feet 700/1050 Linear Feet 350

No Lines 5@70' Trench Width 24" MIN Bottom Max Trench Bottom Depth 36" Gravel Depth NA

☒ New System ☐ Repair System Type: I, II, III, (IV), V, VI

System Description: LP PPBPS

Repair System Description: LP PPBPS

Maintenance Agreement Required: ☒ Yes ☐ No

☒ House/Mod. Home No. Bedrooms 4

☐ Mobile Home No. Bathrooms

☐ Business No. Employees

☐ Other

☐ Slab ☒ Crawl Space ☐ Basement w/plumbing ☐ Basement wo/plumbing

Water Supply: ☒ Individual ☐ Public ☐ Community

Comments:/Conditions: OR = 36" MAX 9'oc


Limited site evaluation and system design performed by Mike Athanas LSS and Ashley Pollard, LSS.

Comments:/Conditions:

INITIAL SITE SKETCH

SEE Plan by Mike Athanas & Ashley Pollard

AS BUILT SKETCH

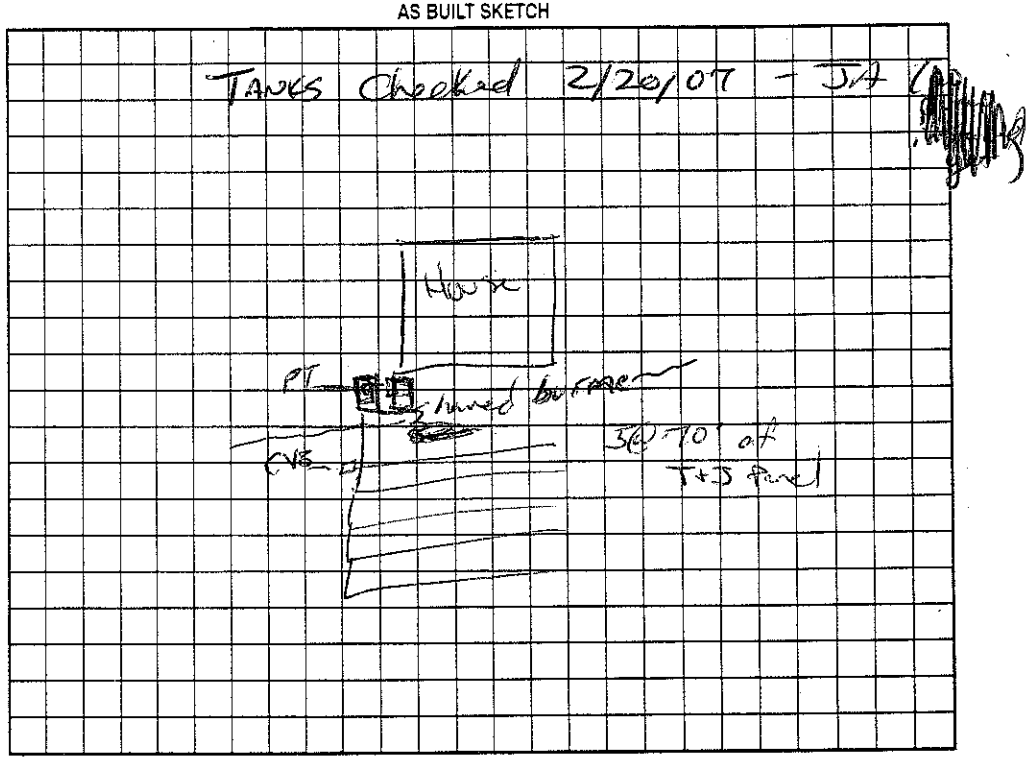

Permit can be suspended or revoked if any false information is supplied toward securing the permit/any unauthorized changes are made to the site/any unauthorized changes are made in the installation of the system. Improvement Permit with plat valid without expiration. Improvement Permit with site plan valid for sixty months. Authorization to Construct is valid for a period equal to that of Improvement Permit – not to exceed sixty months.

Signed: date 9-28-05 Installed by: Specialty Septic

Improvement Permit by: date 9-16-05 Operation Permit by: Wesley Sparks R.S. date 8/9/07

Authorization to Construct by: date 7/6/06 Existing System Inspection by: date

HEALTH DEPT COPY: WHITE OWNER COPY (FINAL): YELLOW OWNER COPY (INITIAL): PINK