IREDELL COUNTY HEALTH DEPARTMENT

Redraw / CI 3:30-4:00

STATESVILLE 704-878-5305 MOORESVILLE 704-664-5281

IMPROVEMENT PERMIT / AUTHORIZATION TO CONSTRUCT / OPERATION PERMIT / EXISTING SYSTEM INSPECTION

PERMIT# 129409 PIN# 4648236167.000 DATE 10/4/07

OWNER OR APPLICANT Matthay Ward Bldg, LLC PHONE: Business 704 902 3907 Home 704 828 4789514

ADDRESS 3824 Goodrost. Torrell NC 28682

LOCATION 150W TR Bluefield Rd TL Big Indian Loop TR Palos Verde Dr. 3rd Lot on Right

SUBDIVISION Palos Verde BLOCK / SECTION LOT #16 LOT AREA .60 ac SITE CLASS PS DESIGN FLOW 480 L.T.A.R. .3

Septic Tank: 1000 Gallons: STB 1012 Date 5-20-07

Pump Tank: Gallons: PT Date

Pump Make: Model Serial No.

Nitrification Field: No Fields Square Feet 540/810 Linear Feet 270

No Lines 3+3 Trench Width 24" min of 36" max Max Trench Bottom Depth 36"

☑ New System ☐ Repair ☐ Expansion System Type: I II (III) IV V VI

System Description: Gravity PPBPS

Repair System Description: LPPPBPS

Maintenance Agreement Required: ☐ Yes ☑ No Initial

Gravel Depth N/A ☑ Gravity ☐ Pressure ☐ Slab ☑ Crawl Space ☐ Basement w/plumbing ☐ Basement wo/plumbing

☑ House/Mod. Home ☐ Mobile Home ☐ Business ☐ Other

No. Bedrooms 4 No. Persons No. Employees

Water Supply: ☑ Individual ☐ Public ☐ Community

Comments./Conditions:


Initial site evaluation & layout performed by Mike Athanas LSS and Ashley Rollins, LSS use flow divider and distribution box, set tank for gravity flow or a pump will be required.

Comments:/Conditions:


* Shave any old field terraces/berms in septic area.

Yellow filter

INITIAL SITE SKETCH

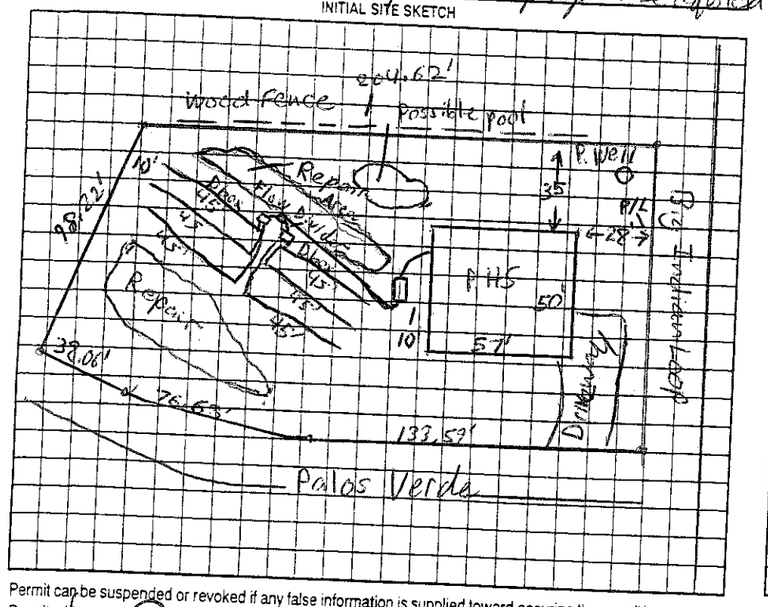

AS BUILT SKETCH

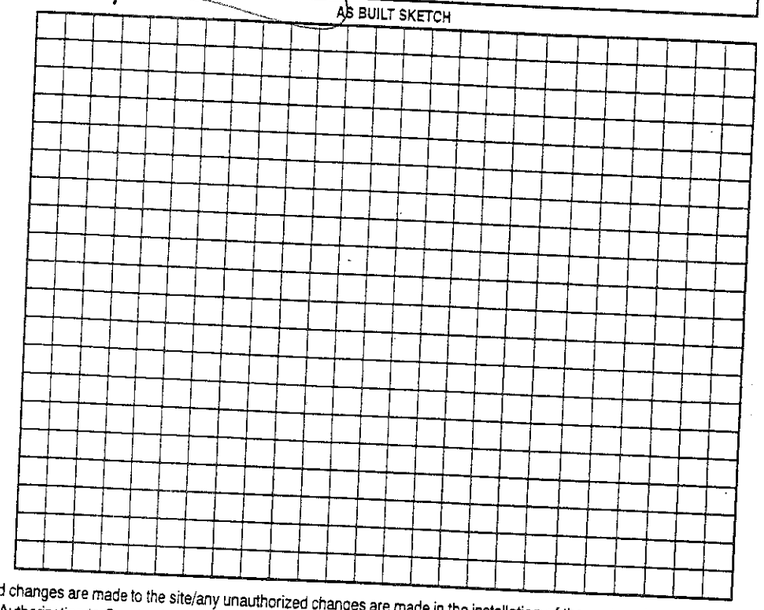

Permit can be suspended or revoked if any false information is supplied toward securing the permit/any unauthorized changes are made to the site/any unauthorized changes are made in the installation of the system. Improvement Authorization to Construct is valid for a period equal to that of Improvement Permit – not to exceed sixty months.

Permit with plat valid without expiration ☐ Improvement Permit with site plan valid for sixty months ☑

Signed: date 10-9-07

Improvement Permit by: Anthony Cobern Jr. date 10/4/07

Authorization to Construct by: Anthony Cobern Jr. date 10/4/07

Installed by: [redacted] Tommy Frye

Operation Permit by: Ronny Moore date 4/22/07

Existing System Inspection by: date

HEALTH DEPT. COPY: WHITE OWNER COPY (FINAL): YELLOW OWNER COPY (INITIAL): PINK