Redraw

IREDELL COUNTY HEALTH DEPARTMENT

STATESVILLE 704-878-5305 MOORESVILLE 704-664-5281

IMPROVEMENT PERMIT / AUTHORIZATION TO CONSTRUCT / OPERATION PERMIT / EXISTING SYSTEM INSPECTION

PERMIT# 129405 PIN# 4648237422.000 DATE 10/4/07

OWNER OR APPLICANT Maltby Ward Bldg LLC PHONE: Business 704 902 3707 Home 828 478 9514

ADDRESS 3624 Gordon St, Terrell NC 28682

LOCATION 150 w TR Bluefield Rd. TL Big Indian Loop TR Palos Verde Dr. 3rd Lot on Right

SUBDIVISION Palos Verde BLOCK / SECTION ____ LOT 14 LOT AREA .694ac SITE CLASS. PS DESIGN FLOW 480 L.T.A.R. .3 Initial/.25 Repair

Septic Tank: 1000 Gallons; STB 1012 Date 10/12/07

Pump Tank: 1000 Gallons; PT 1000 Date 7/1/08

Pump Make: Goulds Model PES1 Serial No. C083490

Nitrification Field: No Fields 1 Square Feet 1200 Linear Feet 400'

No Lines 5@80' Trench Width 36" Max Trench Bottom Depth 36" Gravel Depth NA ☐ Gravity ☐ Pressure

☑ New System ☐ Repair ☐ Expansion System Type: I II III IV V VI

System Description: PM 25% Reduction

Repair System Description: Same

Maintenance Agreement Required: ☐ Yes ☑ No

☑ House/Mod. Home No. Bedrooms 4

☐ Mobile Home No. Persons ____

☐ Business No. Employees ____

☐ Other ____

Water Supply: ☑ Individual ☐ Public ☐ Community

☐ Slab ☑ Crawl Space ☐ Basement w/plumbing ☐ Basement wo/plumbing

Comments:/Conditions: Shave any old berms in septic area initial site evaluation + layout performed by Mike Athanas, LSS and Ashley Rollans, LSS


Comments:/Conditions: *App. is switching location of drive way and well. AC 10/10/07

yellow fitter

*moved P. manifold to back left corner of property & ran supply line up left side. 5/14/08 R.M.

Scale = 1" = 60' INITIAL SITE SKETCH

AS BUILT SKETCH

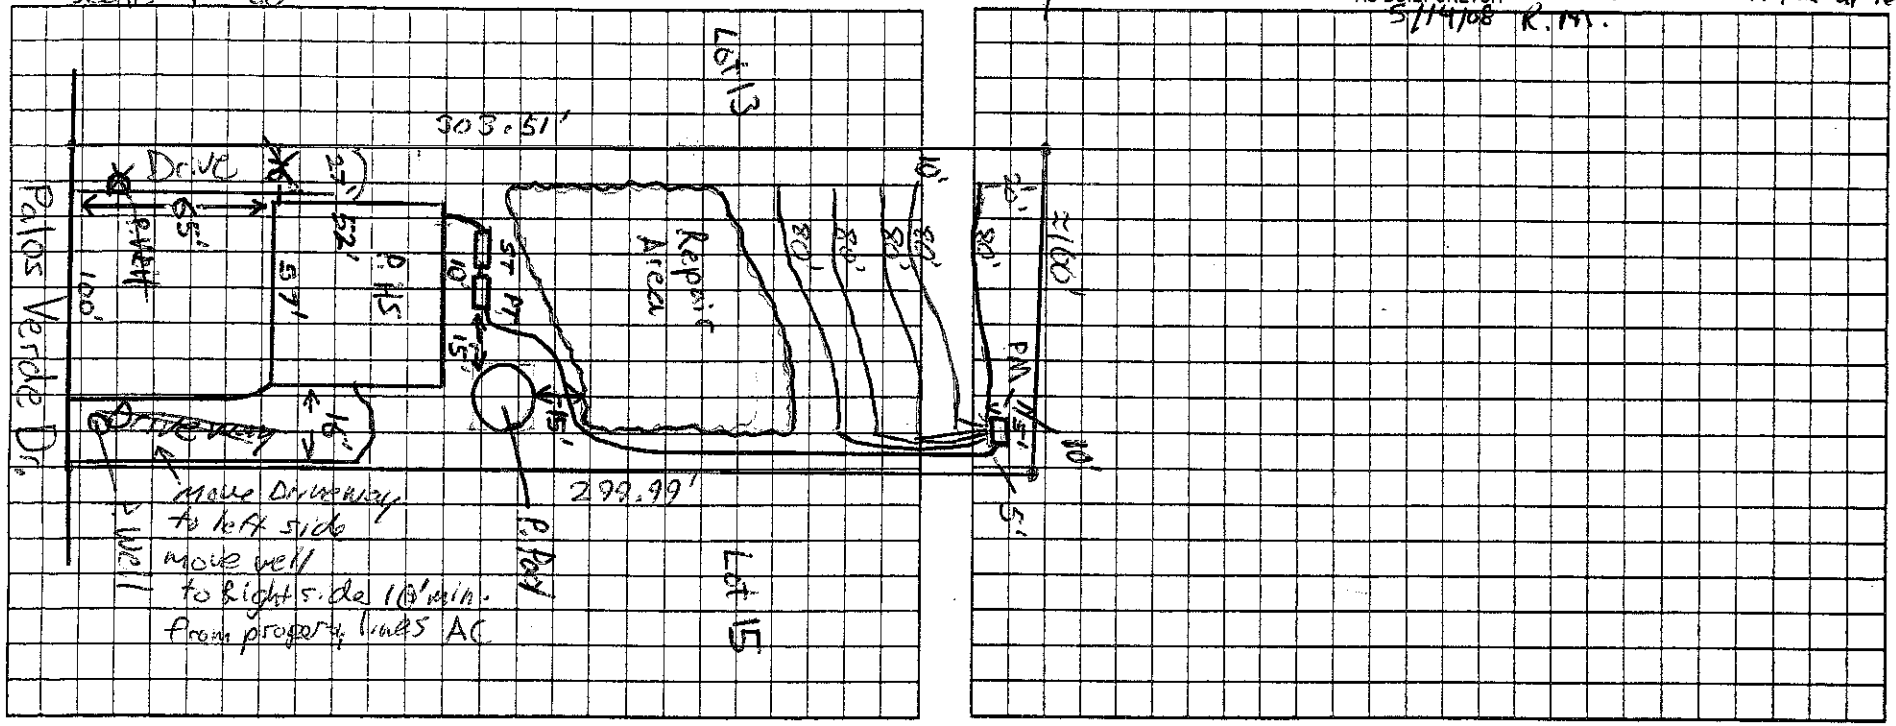

Permit can be suspended or revoked if any false information is supplied toward securing the permit/any unauthorized changes are made to the site/any unauthorized changes are made in the installation of the system. Improvement Permit with plat valid without expiration ☐ Improvement Permit with site plan valid for sixty months ☑ Authorization to Construct is valid for a period equal to that of Improvement Permit – not to exceed sixty months.

Signed: ____ date 10-9-07 Installed by: Tommy Frye

Improvement Permit by: Anthony Cokers date 10/4/07 Operation Permit by: Ramm date 7/14/08

Authorization to Construct by: Anthony Cokers date 10/9/07 Existing System Inspection by: ____ date ____

HEALTH DEPT. COPY: WHITE OWNER COPY (FINAL): YELLOW OWNER COPY (INITIAL): PINK