IREDELL COUNTY HEALTH DEPARTMENT

STATESVILLE 704-878-5305 / 130.00 Paid MOORESVILLE 704-664-5281

IMPROVEMENT PERMIT / AUTHORIZATION TO CONSTRUCT / OPERATION PERMIT / EXISTING SYSTEM INSPECTIO

PERMIT# 129400 PIN# 4648 23 7553 DATE August 30, 05

OWNER OR CONTRACTOR Ward Diversified Services / Daden Construct PHONE: Business _____ Home _____

ADDRESS 8156 Mombo Rd, Catawba, NC. 28609

LOCATION 150 W TR Bluefield Rd. TL Big Indian Loop TR Palos Verde Dr. 4th Lot on Right

SUBDIVISION Palos Verde BLOCK / SECTION _____ LOT 13 LOT AREA 30,148 ft² SITE CLASS. B DESIGN FLOW 450gpd L.T.A.R. .03

Septic Tank: 1000 Gallons; STB 1007 Date 6/5/06
Pump Tank: 1000 Gallons; PT 574 Date 4/25/06
Pump Make: Little Giant Model 9EH Serial No. _____
Nitrification Field: No Fields 1 Square Feet 1200 Linear Feet 400
No Lines 5@80 Trench Width 36" Max Trench Bottom Depth 36" Gravel Depth N/A

☒ New System ☐ Repair System Type: I II III IV V VI
System Description: pm 25% Reduction
Repair System Description: pm or LP PPBPS
Maintenance Agreement Required: ☐ Yes ☒ No

☒ House/Mod. Home No. Bedrooms 4
☐ Mobile Home No. Bathrooms _____
☐ Business No. Employees _____
☐ Other _____
☐ Slab ☒ Crawl Space ☐ Basement w/plumbing ☐ Basement wo/plumbing

Water Supply:
☒ Individual
☐ Public
☐ Community

Comments:/Conditions:
Limited site evaluation and layout performed by Mike Athomas, LSS and Ashley Rollins, LSS.

Comments:/Conditions: 2/1/06 Reviewed Building plans, essentially in compliance with I.P.

INITIAL SITE SKETCH

SEE Plan by Mike Athomas & Ashley Rollins

AS BUILT SKETCH

Infiltrator Quick 4 Installed


Permit can be suspended or revoked if any false information is supplied toward securing the permit/any unauthorized changes are made to the site/any unauthorized changes are made in the installation of the system. Improvement Permit with plat valid without expiration. Improvement Permit with site plan valid for sixty months. Authorization to Construct is valid for a period equal to that of Improvement Permit – not to exceed sixty months.

Signed: _____ date 9-28-05 Installed by: Abernathy

Improvement Permit by: _____ date 8-30-05 Operation Permit by: _____ date 1/8/07

Authorization to Construct by: _____ date 2/1/06 Existing System Inspection by: _____ date _____

HEALTH DEPT. COPY: WHITE OWNER COPY (FINAL): YELLOW OWNER COPY (INITIAL): PINK

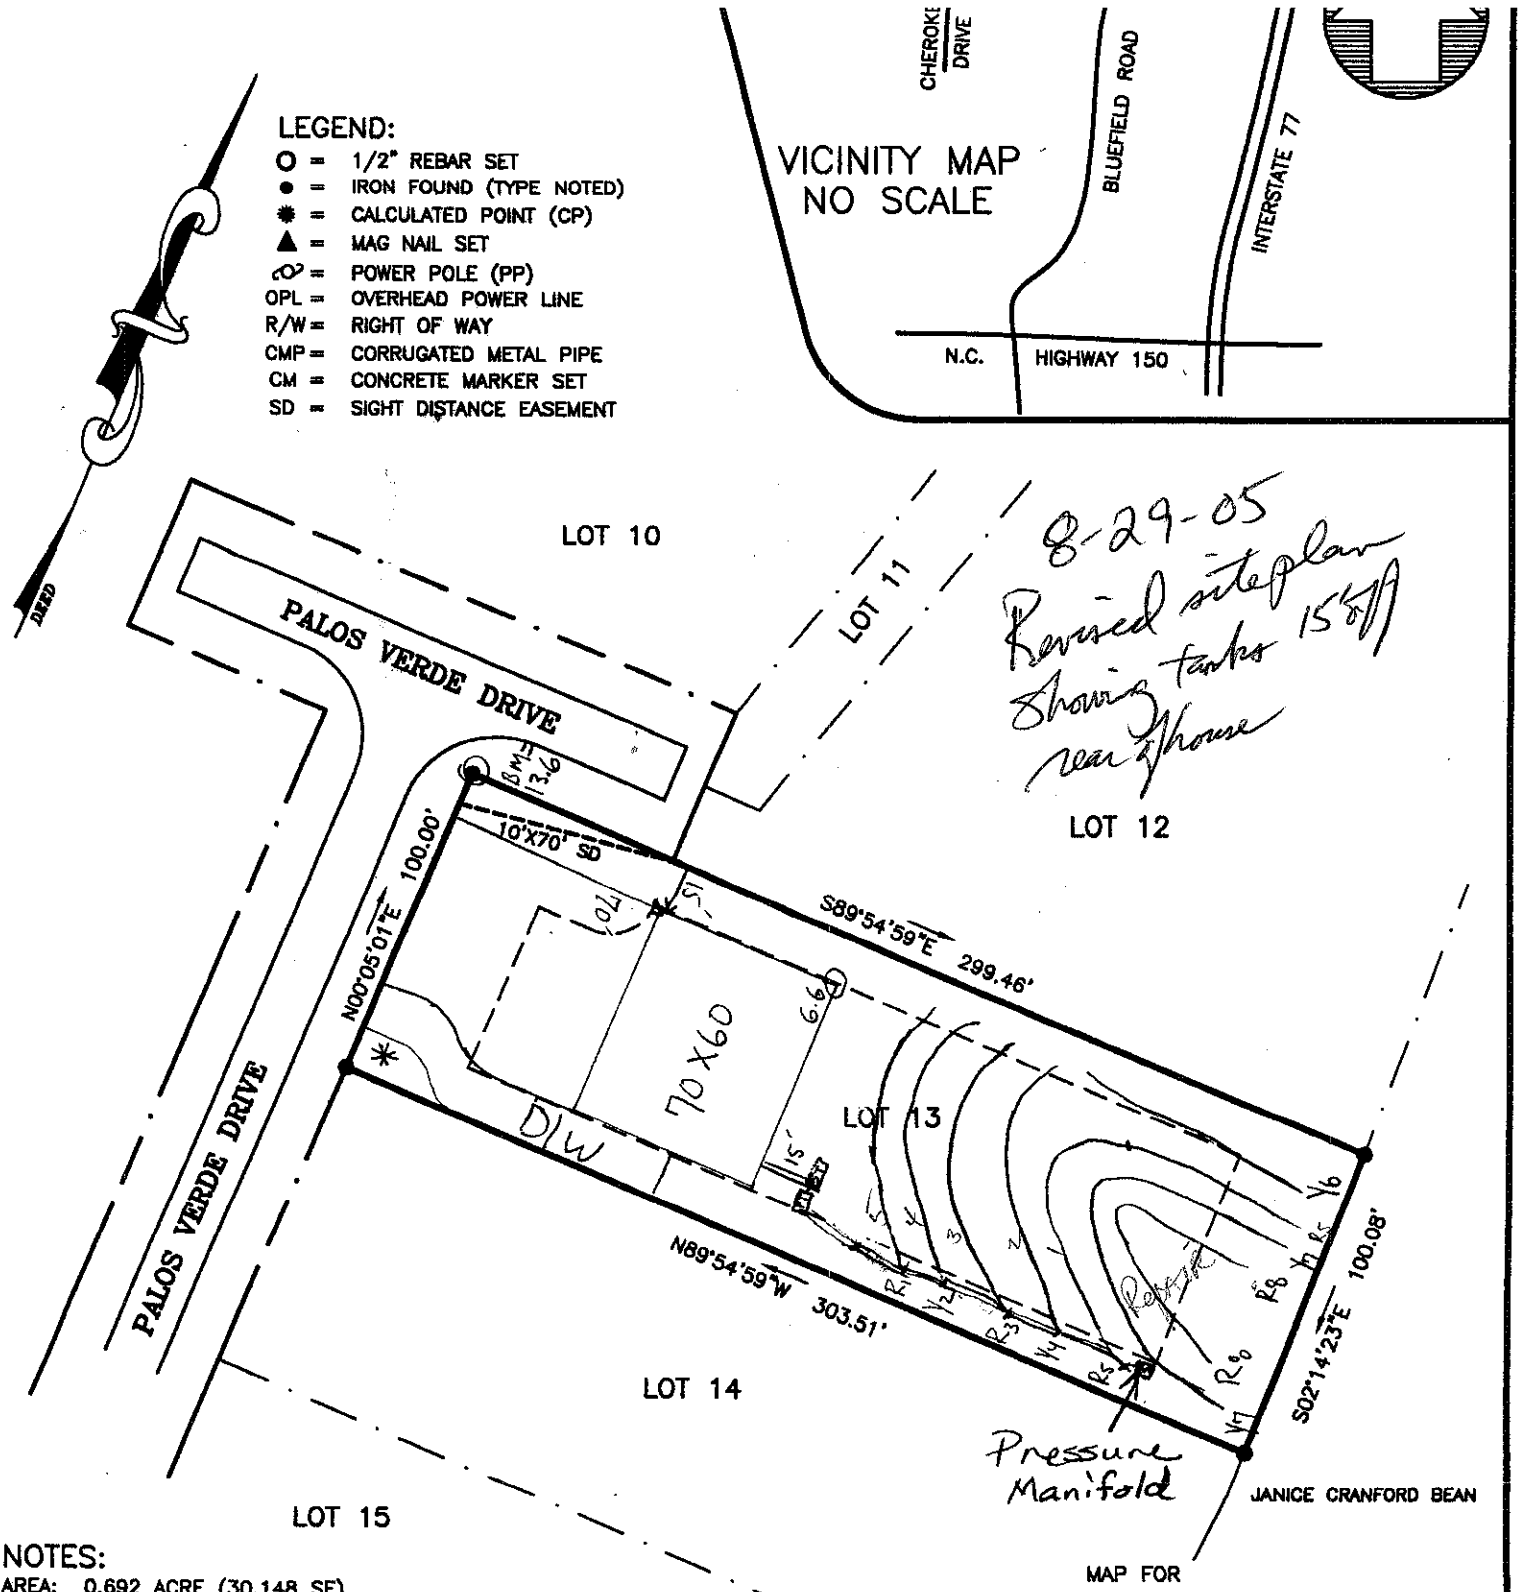

NOTES:

AREA: 0.692 ACRE (30,148 SF)

CURRENT TAX RECORDS ARE USED TO IDENTIFY ADJOINING PROPERTY OWNERS.

THE PROPERTY SHOWN HEREON IS SUBJECT TO ALL EASEMENTS, RIGHT OF WAYS, RESTRICTIONS, AND AGREEMENTS THAT ARE VALID AND ENFORCEABLE NOT SHOWN HEREON.

ALL LOTS ARE SUBJECT TO A TEN FOOT DRAINAGE AND UTILITIES EASEMENT. TEN FEET ON EACH SIDE OF THE PROPERTY LINE.

SURVEYED PROPERTY IS ZONED RA.

1/2" REBAR SET AT ALL PROPERTY CORNERS UNLESS OTHERWISE NOTED.

ALL LOTS ARE DESIGNED FOR SINGLE FAMILY RESIDENTIAL LOTS ONLY.

MAP FOR

LOT 13– PALOS VERDE ESTATES

PALOS VERDE DRIVE-- MOORESVILLE, NC 28117

DAVIDSON TOWNSHIP IREDELL COUNTY NORTH CAROLINA

SCALE: 1"=60' DRAWN BY: TES FILE: 20554-SEPTIC

DEED REFERENCE: BOOK 713 PAGE 926

PIN NUMBER: 4648-23-5441

TAX ZCCOUNT NUMBER: 000067236250

DATE: JUNE 6, 2005

DRAWING NUMBER: P-2-P

MILLER SURVEYING, INC.

234 9th AVENUE DRIVE N.E. HICKORY NC (828-322-4013)