IREDELL COUNTY HEALTH DEPARTMENT

Statesville Office (704) 878-5305 Mooresville Office (704) 660-3625 AMP

PERMIT # 2073872130

IMPROVEMENT PERMIT / AUTHORIZATION TO CONSTRUCT / OPERATION PERMIT / EXISTING SYSTEM

PIN # 4648-23-7553

APPLICANT: JOHN WILSON APPLICANT ADDRESS: 159 FOXTAIL DR.

SITE ADDRESS: 124 PALOS VERDE DR. PHONE: 704-838-6347 ALT. PHONE:

SITE DIRECTIONS: BLUEFIELD, BIG INDIAN LOOP, TR PALOS VERDE, GN R

SUBDIVISION: PALOS VERDE SECTION: LOT # 13 LOT AREA: .692 AC DESIGN FLOW: 480 L.T.A.R.: 3

Septic Tank Ex. 1000 (gal) STB 1007 Date 6-5-06
Pump Tank Ex. 1000 (gal) PT 274 Date 4-25-06
Pump Make LITTLE GIANT Model 9EH Serial #
Nitrification Fields 1 # Lines 1 Linear Ft: 80'
Trench Width 36" Max. Trench Bottom Depth 36" Gravel Depth

☐ New System ☐ Repair ☐ Expansion System Type: I II III IV V VI
System Description: PM 25% REDUCTION
Repair System Description: PANEL BLOCK
Maintenance Agreement Required: ☐ YES ☒ NO ☐ GRAVITY ☒ PRESSURE


☐ Residence ☐ Business ☒ Other ☐ Slab ☐ Basement w/plumbing
No. Bedrooms 4 No. Persons No. Employees ☒ Crawl Space
☐ Basement w/o plumbing

Water Supply: ☒ Private ☐ Public ☐ Community


Comments / Conditions: * PM MAY NEED TO BE RELOCATED
* PATIO MUST BE 5' FROM DRAIN LINES
INSTALLED QUICK

OUTDOOR PATIO & FIRE PLACE

INITIAL SITE SKETCH

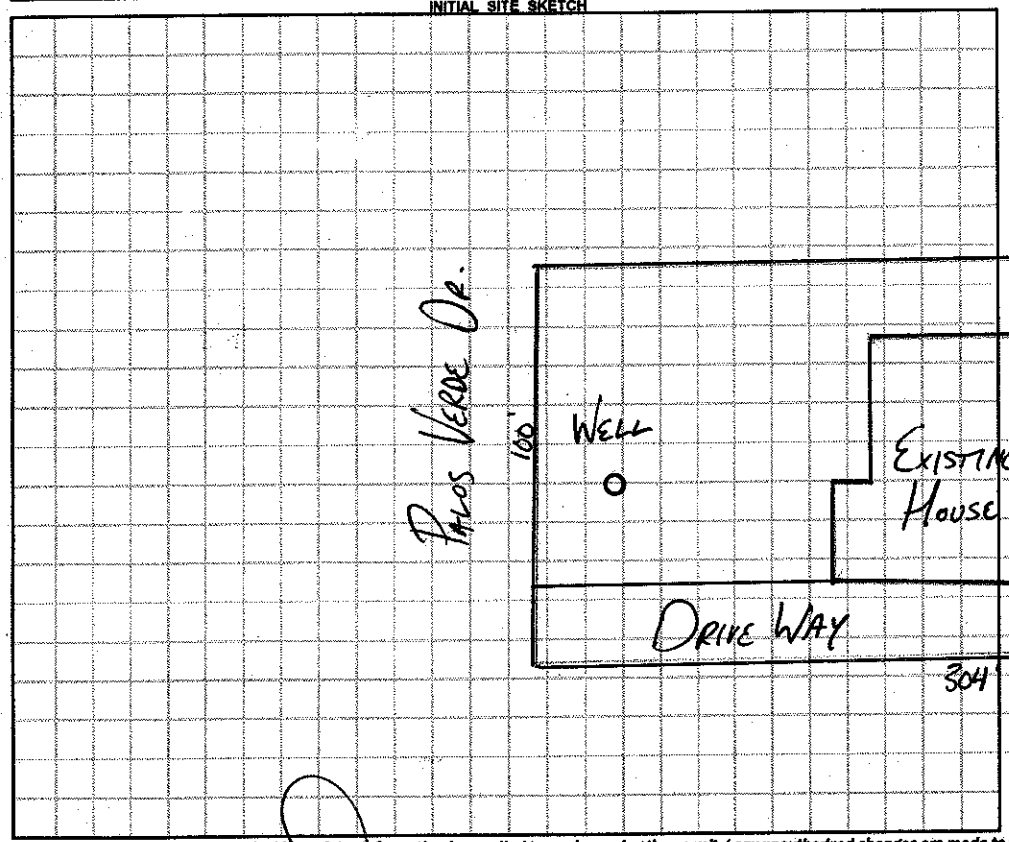

AS BUILT SKETCH

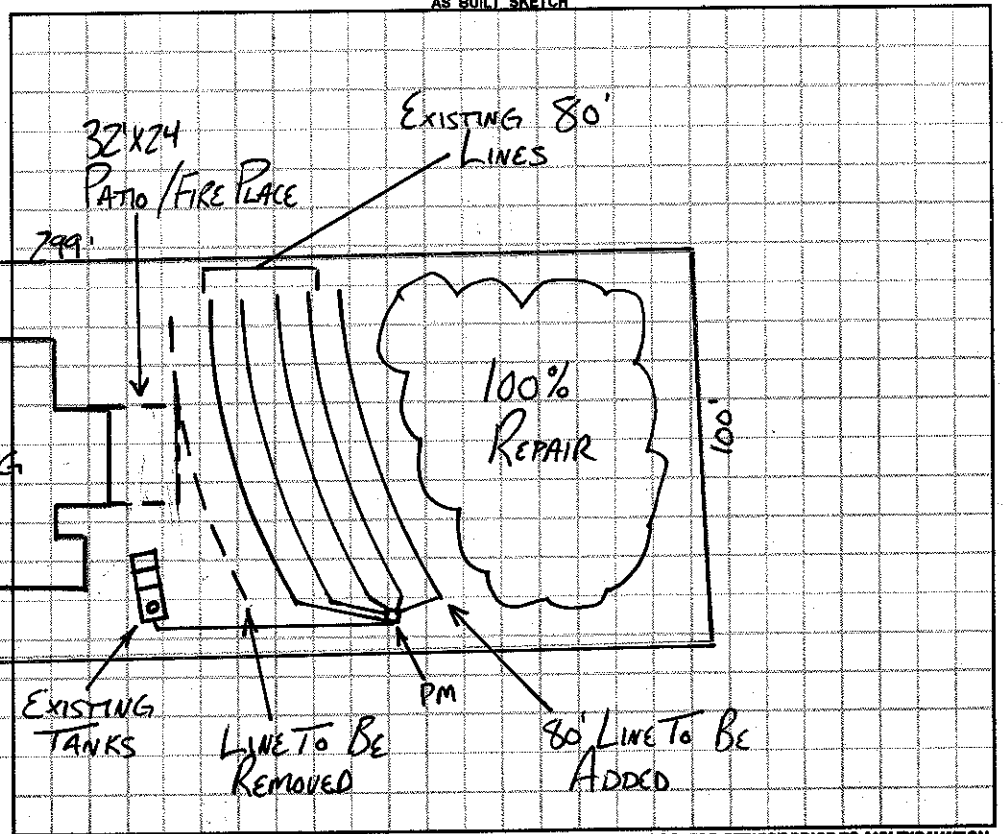

Permit can be suspended or revoked if any false information is supplied toward securing the permit / any unauthorized changes are made to the site / any unauthorized changes are made in the installation of the system. **CONTACT A LOCATOR SERVICE PRIOR TO ANY EXCAVATION**

☐ **IMPROVEMENT PERMIT** *with plat valid without expiration.* ☐ **IMPROVEMENT PERMIT** *with site plan valid for 60 mos.* ☒ **AUTHORIZATION TO CONSTRUCT** *valid for period equal to IMPROVEMENT PERMIT--not to exceed 60 mo.*

Owner / Applicant Signature: Date: 1/13/15 Installed by: Specialty Septic

IMPROVEMENT PERMIT by: APPROVED Date: JAN 07 2014 OPERATION PERMIT by: Marvin Dotson RS Date: 1/22/15

AUTHORIZATION TO CONSTRUCT by: APPROVED Date: JAN 07 2014 Existing System Inspected by: Date:

Health Dept. Copy - WHITE Applicant (Final Approval) - YELLOW Applicant (Conditional Approval) - PINK