IREDELL COUNTY HEALTH DEPARTMENT

Authorization to Construct

STATESVILLE 704-878-5305 MOORESVILLE 704-664-5281

IMPROVEMENT PERMIT / ~~CERTIFICATE OF COMPLETION~~ / OPERATION PERMIT / EXISTING SYSTEM INSPECTION

PROPERTY DESCRIPTION NO. 22667 DATE 3/21/96 TAX MAP NO. 2P 6A 39+40 Watershed: ☐ Yes ☒ No

OWNER OR CONTRACTOR Jack + Shirley Edwards ~~PHONE: Business~~ 4648-24-4094 Home 875-0680

ADDRESS 133 Little Indian Loop Mooresville, NC. 28115

LOCATION (R) just + Big Indian Loop ground-hog cove to 10th lot on (L)

SUBDIVISION Indian Hills BLOCK / SECTION Ph 3 LOT 39+40 LOT AREA 1.25 ac SITE CLASS. PS DESIGN FLOW 360 L.T.A.R. .3

Septic Tank: 1000 Gallons; STB 794 Date 1/12/96

Pump Tank: ____ Gallons; PT ____ Date ____

Pump Make: ____ Model ____ Serial No. ____

Nitrification Field: No Fields 1 Square Feet ~~900~~ 1200 Linear Feet ~~300~~

No Lines 3 Trench Width 36" Max Trench Bottom Depth 36" Gravel Depth 6" ~~SAND~~

☐ New System ☐ Repair System Type: I. II (III) IV. V. VI

System Description: ~~X~~ Chamber Plastic

Repair System Description: Pressure - PPBS 16"

Maintenance Agreement Required: ☐ Yes ☒ No

☒ Slab ☐ Crawl Space ☒ Basement w/plumbing ☐ Basement wo/plumbing

☒ House/Mod. Home No. Bedrooms 3

☐ Mobile Home No. Bathrooms 2.5

☐ Business No. Employees ____


☐ Other ____

Water Supply: ☒ Individual ☐ Community ☐ Public


Comments: ~~X~~ Sand backfill required to top of louvers on each section of drainfield material

Comments:

INITIAL SITE SKETCH 1" = 50'

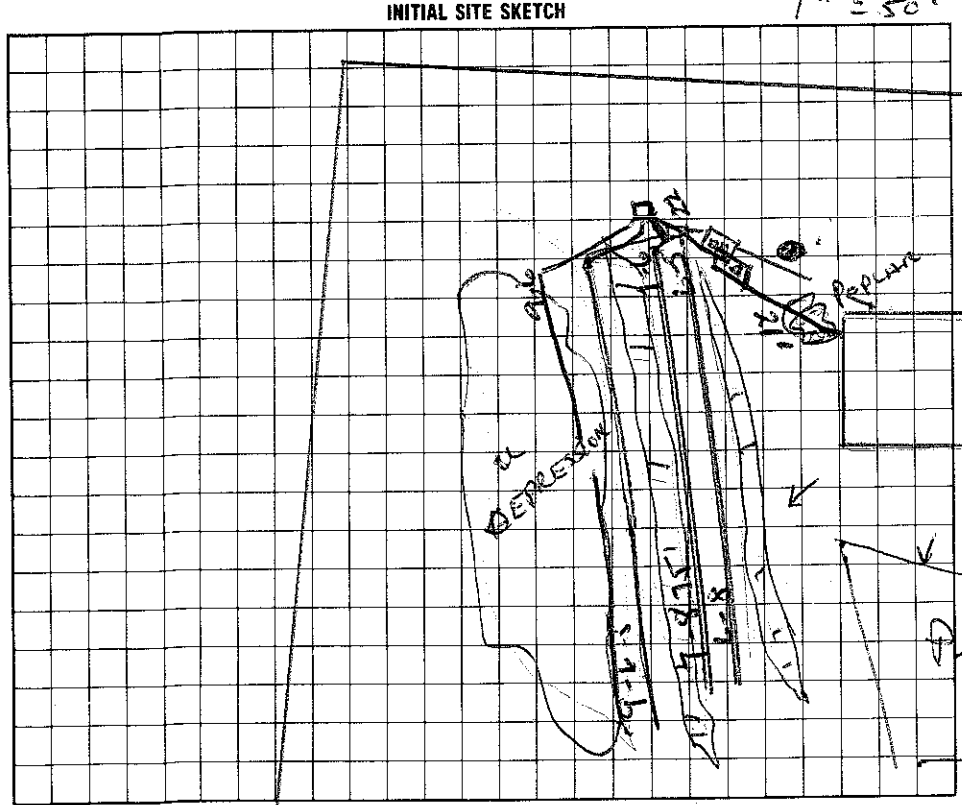

AS BUILT SKETCH

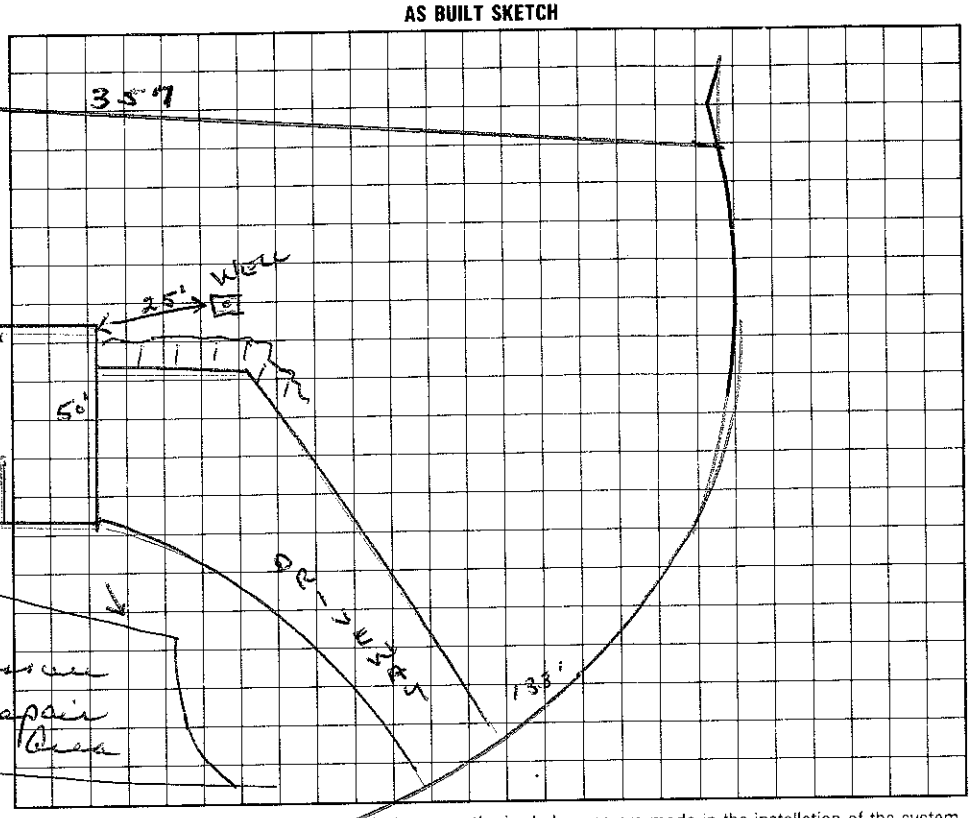

I understand that this permit can be suspended or revoked if any false information is supplied toward securing the permit/any unauthorized changes are made to the site/any unauthorized changes are made in the installation of the system.

Authorization to construct valid for 5 years.

Signed: ____ Installed by: Bob Mayhew

Improvement Permit by: Wesley Sparks RS date 3/21/96 Certificate of Completion by: ____ date ____

Existing System Inspection by: Wesley Sparks RS date 3/21/96 Operation Permit by: Wesley Sparks RS date 10/15/96

HEALTH DEPT. COPY: WHITE INSPECTION COPY (FINAL): GREEN OWNER COPY (FINAL): YELLOW INSPECTION COPY (INITIAL): PINK OWNER COPY (INITIAL): GOLD