IREDELL COUNTY HEALTH DEPARTMENT

STATESVILLE 704-878-5305 MOORESVILLE 704-664-5281

IMPROVEMENT PERMIT / CERTIFICATE OF COMPLETION / OPERATION PERMIT / EXISTING SYSTEM INSPECTION

PROPERTY DESCRIPTION NO. 20223 DATE 3/2/95 TAX MAP NO. 2P - B - 26 Pt of. Watershed: ☐ Yes ☑ No

OWNER OR CONTRACTOR John Freeze ~~PHONE: Business~~ 4648-24-6026 Home 663-3655

ADDRESS 522 Ruben Hwy Mooresville NC.

LOCATION Big Lndian Lp., TL on Big Lndian from Bluefield Rd. straight around curve ~.4 mile on (12)

SUBDIVISION Lndian Hill BLOCK / SECTION PH III LOT 38 LOT AREA ~.65 AC. SITE CLASS P DESIGN FLOW 360 L.T.A.R. .3

Septic Tank: 1000 Gallons; STB ____ Date ____

Pump Tank: ____ Gallons; PT ____ Date ____

Pump Make: ____ Model ____ Serial No. ____

Nitrification Field: No Fields 1 Square Feet 1200 Linear Feet ~~300~~

No Lines 5 Trench Width 36" Max Trench Bottom Depth 36" Gravel Depth 12"

☑ New System ☐ Repair System Type: I, (II), III, IV, V, VI

System Description: CONV - DIST BOX

Repair System Description: Same area/Panels

Maintenance Agreement Required: ☐ Yes ☑ No

☑ House/Mod. Home No. Bedrooms 3

☐ Mobile Home No. Bathrooms 2.5

☐ Business No. Employees ____

☐ Other ____

☐ Slab ☑ Crawl Space ☐ Basement w/plumbing ☐ Basement wo/plumbing


Water Supply: ☑ Individual ☐ Community ☐ Public

Comments: ~~&~~ 25% reduction for INFILTRATOR

Add Changed to 5 @ 40'x3' chamber trenches 6/23/95

Comments:

INITIAL SITE SKETCH

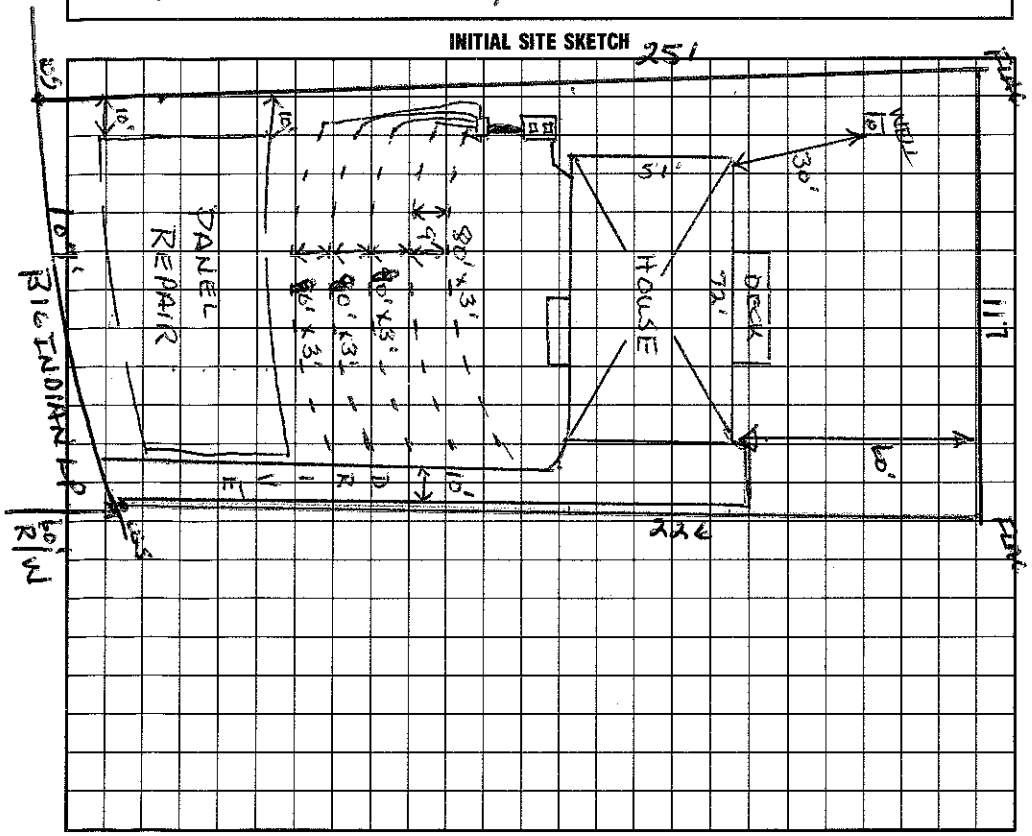

AS BUILT SKETCH

I understand that this permit can be suspended or revoked if any false information is supplied toward securing the permit/any unauthorized changes are made to the site/any unauthorized changes are made in the installation of the system. Improvement Permit is valid for 60 months from date of issuance.

Signed: Thornton Biggs

Improvement Permit by: Wesley Sparks R.S. date 3/2/95

Existing System Inspection by: ____ date ____

Installed by: Ray Beam

Certificate of Completion by: Wesley Sparks R.S. date 11/20/95

Operation Permit by: Wesley Sparks R.S. date 11/20/95

HEALTH DEPT. COPY: WHITE INSPECTION COPY (FINAL): GREEN OWNER COPY (FINAL): YELLOW INSPECTION COPY (INITIAL): PINK OWNER COPY (INITIAL): GOLD