IREDELL COUNTY HEALTH DEPARTMENT

Authorization to Construct

STATESVILLE 704-878-5305 MOORESVILLE 704-664-5281

IMPROVEMENT PERMIT / ~~CERTIFICATE OF COMPLETION~~ / OPERATION PERMIT / EXISTING SYSTEM INSPECTION

PROPERTY DESCRIPTION NO. 20247 DATE 4/11/96 TAX MAP NO. 2P & B 37 Watershed: [X] Yes [ ] No

OWNER OR CONTRACTOR Richard Price PHONE: Business 4648-24-7036 Home 662-3959

ADDRESS 110 Peninsula Pt Ln. Mooresville, NC 28115

LOCATION Big Indian Loop (E) off Blandfield Rd, TR 3 RD lot on (L) past Churchill Ln.

SUBDIVISION Indian Hill BLOCK / SECTION III LOT 370 LOT AREA .65 SITE CLASS. PS DESIGN FLOW 360 L.T.A.R. .3

Septic Tank: 1000 Gallons; STB 797 Date 6/16/98
Pump Tank: _____ Gallons; PT _____ Date _____
Pump Make: _____ Model _____ Serial No. _____
Nitrification Field: No Fields 1 Square Feet 1200 Linear Feet ~~X~~ 300
No Lines 3 Trench Width 36" Max Trench Bottom Depth 36" Gravel Depth 6" SAND

[X] New System [ ] Repair System Type: I, II, (III) IV, V, VI
System Description: ~~X~~ Chambered Plastic
Repair System Description: Panel
Maintenance Agreement Required: [ ] Yes [X] No


[X] House/Mod. Home No. Bedrooms 3
[ ] Mobile Home No. Bathrooms 3
[ ] Business No. Employees ____
[ ] Other _____
[ ] Slab [ ] Crawl Space [ ] Basement w/plumbing [X] Basement wo/plumbing

Water Supply:
[X] Individual
[ ] Community
[ ] Public


Comments: ~ 25% reduction in linear footage

Comments:

INITIAL SITE SKETCH

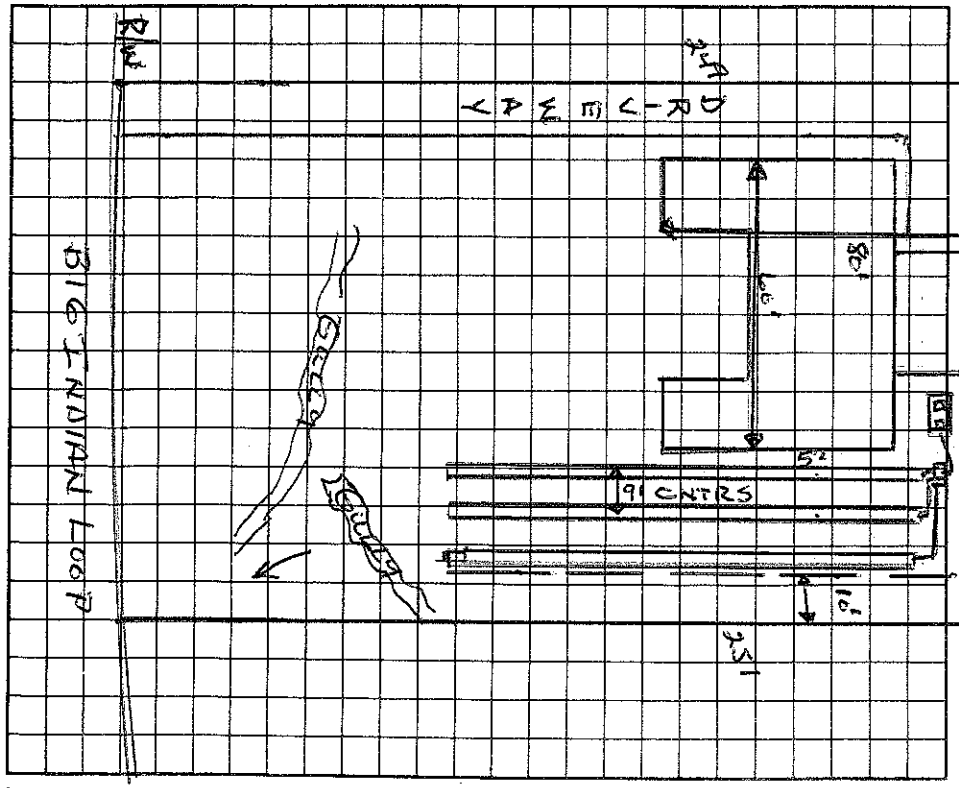

AS BUILT SKETCH

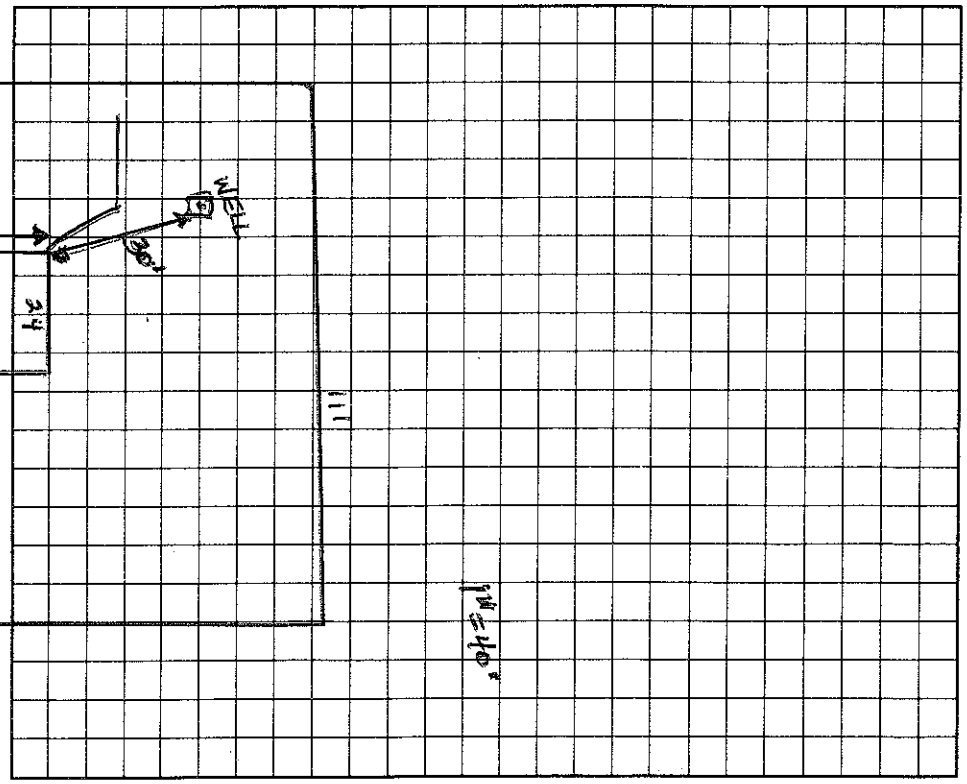

I understand that this permit can be suspended or revoked if any false information is supplied toward securing the permit/any unauthorized changes are made to the site/any unauthorized changes are made in the installation of the system.

Authorization to Construct valid for 5 years.

Signed: Richard L Price

Installed by: KEN MEYER

Improvement Permit by: _____ date _____

Authorization to Construct by: Wesley Sparkes date 4/11/96

Existing System Inspection by: _____ date _____

Certificate of Completion by: _____ date _____

Operation Permit by: C. _____ date 8/24/98

HEALTH DEPT. COPY: WHITE INSPECTION COPY (FINAL): GREEN OWNER COPY (FINAL): YELLOW INSPECTION COPY (INITIAL): PINK OWNER COPY (INITIAL): GOLD