IREDELL COUNTY HEALTH DEPARTMENT

STATESVILLE 704-878-5305 FAX 799-0930 MOORESVILLE 704-664-5281

IMPROVEMENT PERMIT / AUTHORIZATION TO CONSTRUCT / OPERATION PERMIT / EXISTING SYSTEM INSPECTION

PERMIT# 070665 PIN# 4648311856 DATE 1/7/97

OWNER OR CONTRACTOR Roland & Betty Nash PHONE: Business (704) 892-7373 Blue Water Home

ADDRESS 4823 Essex Ct Carmel, IN 46032

LOCATION Hwy 150 TR Bluefield TL onto Big Indian Loop TL Cherokee Dr 3rd From End on left

SUBDIVISION Bear Foot Bay BLOCK / SECTION LOT 17 LOT AREA ± 1 Acre SITE CLASS. PS DESIGN FLOW 480 gpd L.T.A.R. .3+

Septic Tank: 1000 Gallons; STB 825 Date 12-11-99

Pump Tank: 1000 Gallons; PT 302 Date 12-14-99

Pump Make: Zoeller Model Serial No.

Nitrification Field: No Fields 1 Square Feet 560' Linear Feet 280'

No Lines 4 at 70' Trench Width 24" Max Trench Bottom Depth 30" Gravel Depth N/A

X New System ☐ Repair System Type: I, II, III, IV, V, VI

System Description: Pump - Panel Block

Repair System Description: Same

Maintenance Agreement Required: X Yes ☐ No

X House/Mod. Home No. Bedrooms 4

☐ Mobile Home No. Bathrooms

☐ Business No. Employees

☐ Other Partial


☐ Slab X Crawl Space ☐ Basement w/plumbing X Basement wo/plumbing

Water Supply: X Individual ☐ Public ☐ Community


Comments:/Conditions: Keep well 50'+ from Septic System & water line at least 10' from Sewer lines. House needs to be located 150' from Rd. Well must be "Drilled Well"

Comments:/Conditions: Pressure Checked 2/9/2000 Tanks & lines Checked 2/9/2000

INITIAL SITE SKETCH Scale: 1:50

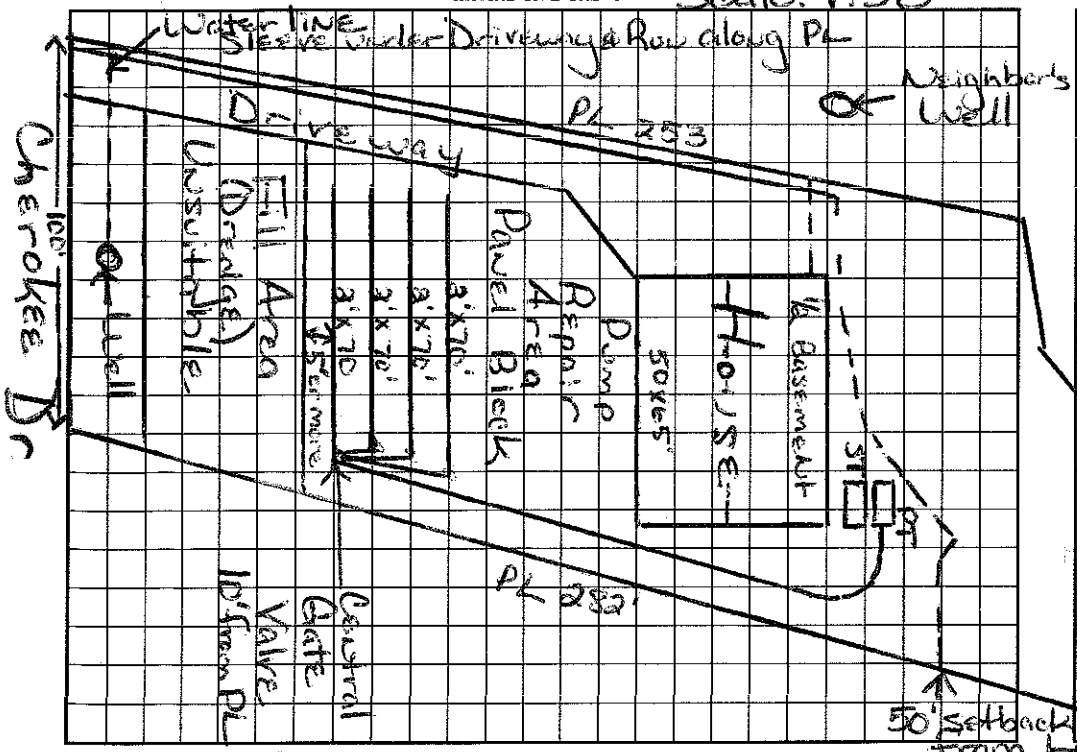

AS BUILT SKETCH

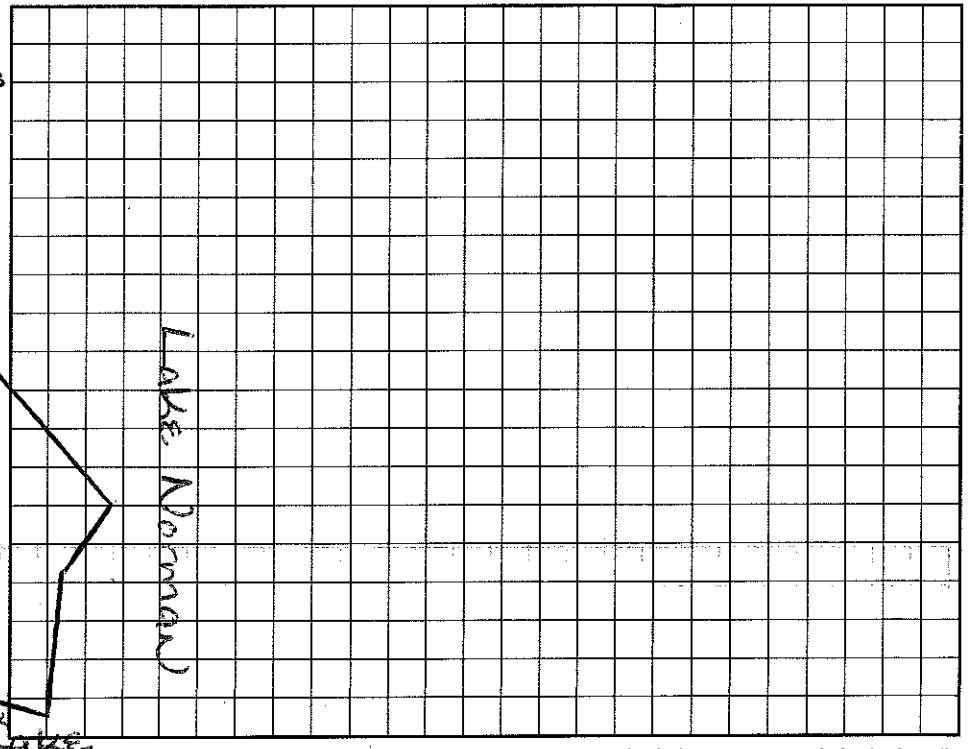

I understand that this permit can be suspended or revoked if any false information is supplied toward securing the permit/any unauthorized changes are made to the site/any unauthorized changes are made in the installation of the system. Improvement Permit with plat valid without expiration. Improvement Permit with site plan valid for sixty months. Authorization to Construct is valid for a period equal to that of Improvement Permit – not to exceed sixty months.

Signed: Lisa McRae date 1-23-98

Improvement Permit by: Maria H. Dotson date 1/8/97

Authorization to Construct by: Maria H. Dotson date 1/8/97

Installed by: Meyers Septic

Operation Permit by: Wesley Parks RS. date 6/8/00

Existing System Inspection by: date

HEALTH DEPT. COPY: WHITE INSPECTION COPY (FINAL): GREEN OWNER COPY (FINAL): YELLOW INSPECTION COPY (INITIAL): PINK OWNER COPY (INITIAL): GOLD