IREDELL COUNTY HEALTH DEPARTMENT

Authorization to Construct

STATESVILLE 704-878-5305 | MOORESVILLE 704-664-5281

PIN# 4648-32-6153

IMPROVEMENT PERMIT / ~~CERTIFICATE OF COMPLETION~~ / OPERATION PERMIT / EXISTING SYSTEM INSPECTION

PROPERTY DESCRIPTION NO. 23081 DATE 6/3/96 TAX MAP NO. 2P 10 A 11 Watershed: [X] Yes [ ] No

OWNER OR CONTRACTOR Wade Cook PHONE: Business _____ Home 663-5559

ADDRESS 475 Big Indian Loop Mooresville, NC. 28115

LOCATION 150 TR Bluefield Rd. TL Big Indian Loop TL Cherokee Dr. to 10 lot on Lt.

SUBDIVISION Beaufort Bay BLOCK/ SECTION _____ LOT 11 LOT AREA .579AC SITE CLASS. PS DESIGN FLOW 360 L.T.A.R. .3

Septic Tank: 1000 Gallons; STB 744 Date 10/7/97

Pump Tank: _____ Gallons; PT _____ Date _____

Pump Make: _____ Model _____ Serial No. _____

Nitrification Field: No Fields 1 Square Feet 1200 Linear Feet 400

No Lines 5 Trench Width 36" Max Trench Bottom Depth 30" Gravel Depth 12"

[X] New System [ ] Repair System Type: I, II, III, IV, V, VI

System Description: CONV - DIST BOX

Repair System Description: Ch. Plastic

Maintenance Agreement Required: [ ] Yes [X] No

[X] House/Mod. Home No. Bedrooms 3

[ ] Mobile Home No. Bathrooms 3

[ ] Business No. Employees ____

[ ] Other _____


[ ] Slab [X] Crawl Space [ ] Basement w/plumbing [ ] Basement wo/plumbing

Water Supply: [X] Individual [ ] Community [ ] Public


Comments:

Comments:

INITIAL SITE SKETCH

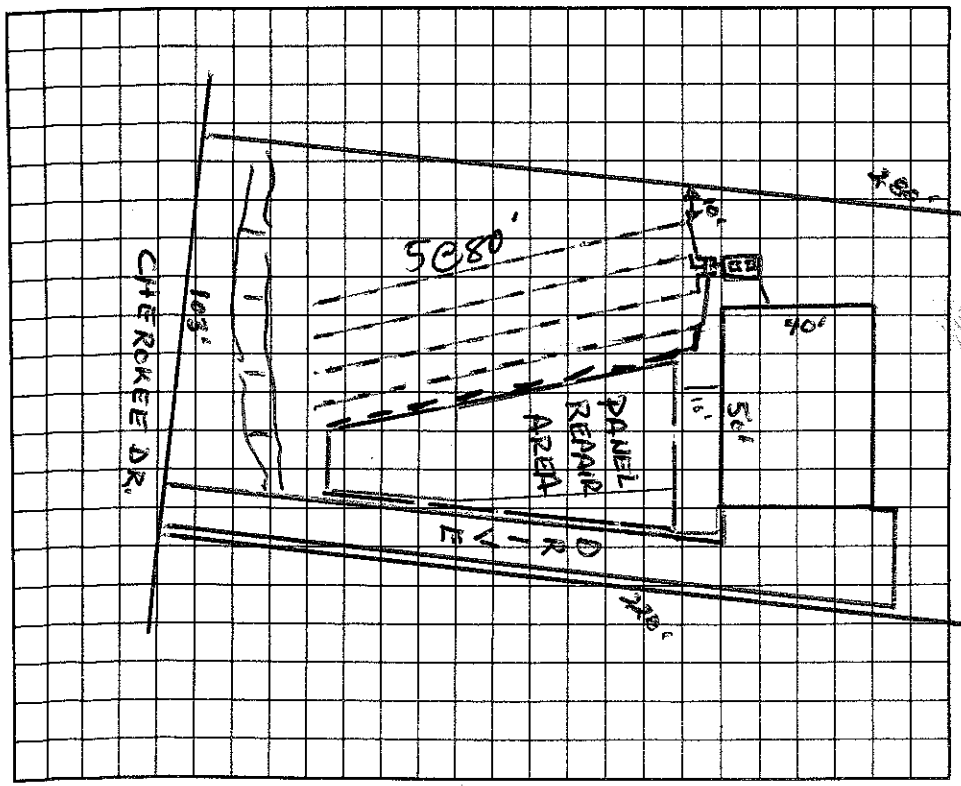

AS BUILT SKETCH

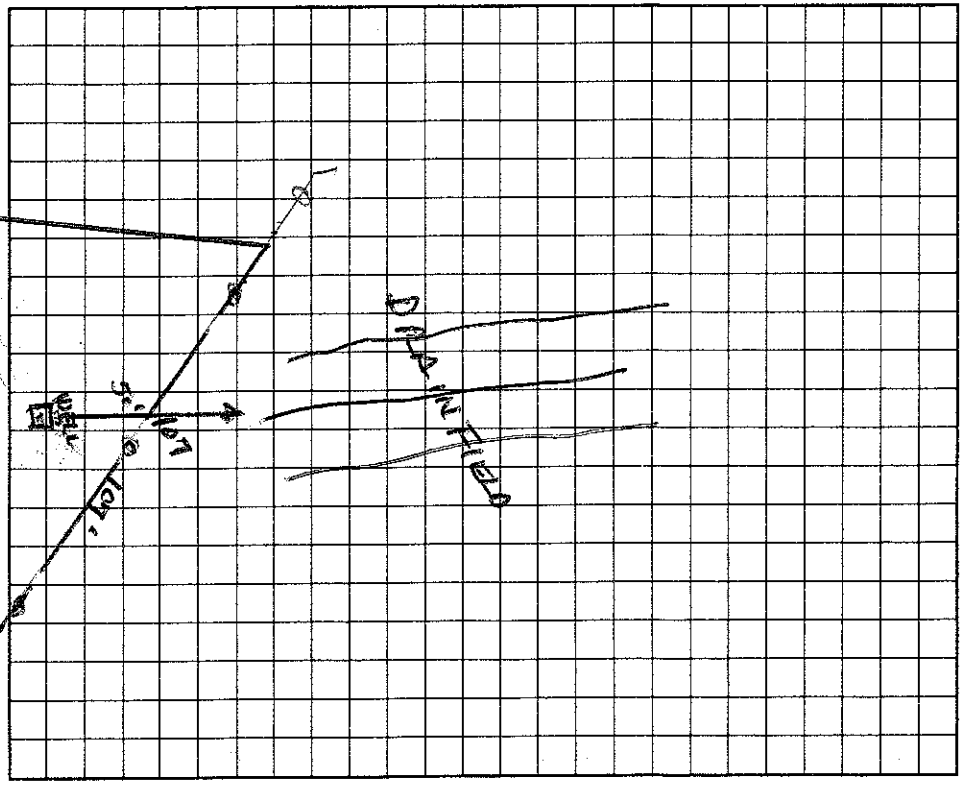

I understand that this permit can be suspended or revoked if any false information is supplied toward securing the permit/any unauthorized changes are made to the site/any unauthorized changes are made in the installation of the system.

Authorization to Construct valid 5 years

Signed: Wade T. Cook

Improvement Permit by: Wesley Sparks RS. date 6/3/96

~~Existing System Inspection by:~~ Construct Wesley Sparks RS date 6/3/96

Installed by: CURT DUNNING

Certificate of Completion by: _____ date _____

Operation Permit by: C. [signature] RS date 2/10/98

HEALTH DEPT. COPY: WHITE | INSPECTION COPY (FINAL): GREEN | OWNER COPY (FINAL): YELLOW | INSPECTION COPY (INITIAL): PINK | OWNER COPY (INITIAL): GOLD