IREDELL COUNTY HEALTH DEPARTMENT

STATESVILLE 704-878-5305 MOORESVILLE 704-664-5281

IMPROVEMENT PERMIT / CERTIFICATE OF COMPLETION / OPERATION PERMIT / EXISTING SYSTEM INSPECTION

PROPERTY DESCRIPTION NO. 18049 DATE July 8, '94 TAX MAP NO. 2L BA11 4648-32-0153 Watershed: ☐ Yes ☐ No

OWNER OR CONTRACTOR Jerry Perdue PHONE: Business Home 552 5115

ADDRESS Beacon Hill Apts Charlotte

LOCATION 1100 TR 1176 (Blume) TR immediately on 1234 (Beechtree) TR lot 1st one at end

SUBDIVISION Beechtree Forest BLOCK / SECTION LOT 11 LOT AREA 2.5Ac SITE CLASS. PS DESIGN FLOW 360 gpd L.T.A.R. .3

Septic Tank: 1000 | 500 Gallons; STB 1014 RST Date 10-1-94

Pump Tank: 1000 Gallons; PT Date

Pump Make: Model Serial No.

Nitrification Field: No Fields 1 Square Feet 1200 Linear Feet 400

No Lines 4 Trench Width 36" Max Trench Bottom Depth 18

☑ New System ☐ Repair System Type: I, II, III, IV, V, VI

System Description: Shallow conventional pumped

Repair System Description: same

Maintenance Agreement Required: ☐ Yes ☑ No

Gravel Depth 12"

☑ House/Mod. Home No. Bedrooms 3

☐ Mobile Home No. Bathrooms 2½

☐ Business No. Employees

☐ Other


☐ Slab ☑ Crawl Space ☐ Basement w/plumbing ☐ Basement wo/plumbing

Water Supply: ☑ Individual ☐ Community ☐ Public


Comments: Septic System note that trenches must be installed 18" trench bottom depth and on contour. Owner desires to fill around house and build up in order to get or try to eliminate pump, this will be determined at time system is installed.

Comments: House area filled & house pad built up enough to accomodate gravity flow on septic system. Well not installed as of this date.

INITIAL SITE SKETCH

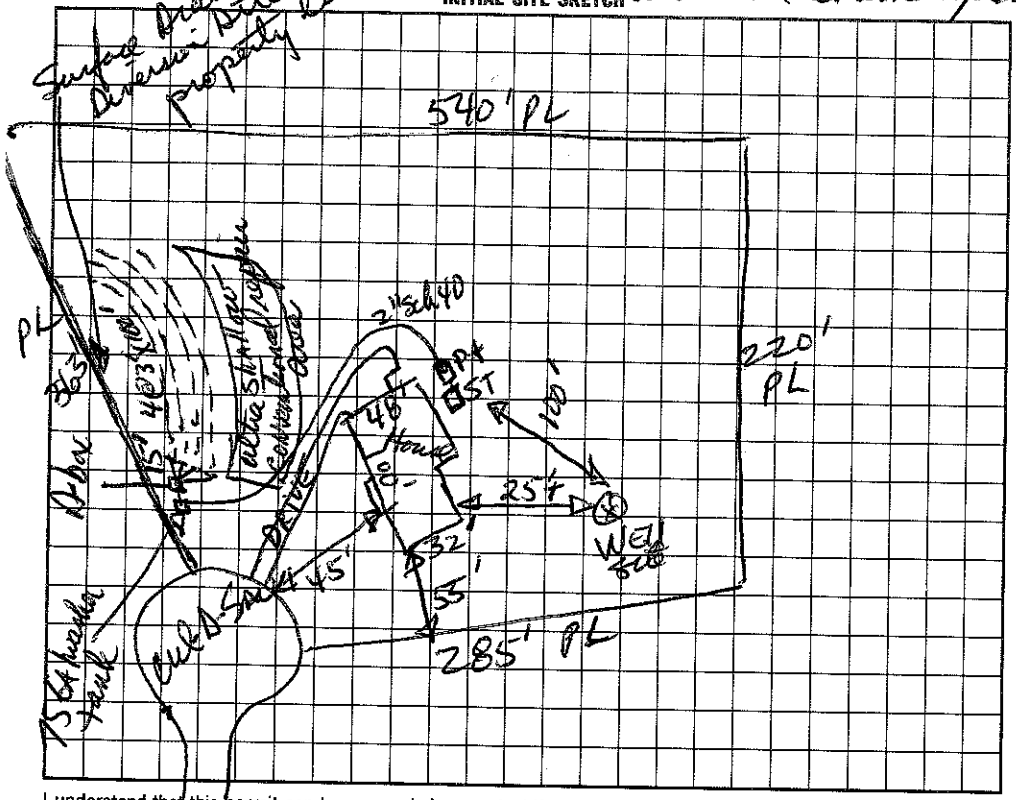

AS BUILT SKETCH

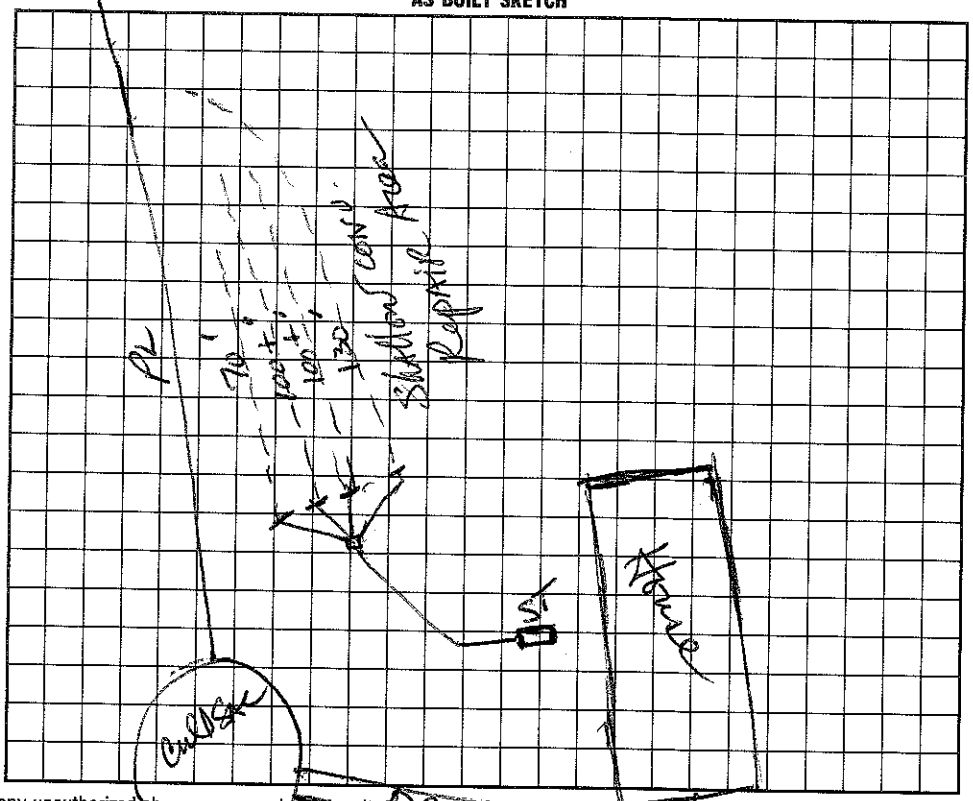

I understand that this permit can be suspended or revoked if any false information is supplied toward securing the permit/any unauthorized changes are made to the site and any unauthorized changes are made in the installation of the system. Improvement Permit is valid for 60 months from date of issuance.

Signed: X

Improvement Permit by: Harold Hunnicutt, RS date 7/8/94

Existing System Inspection by: date

Installed by: Grant Perdue

Certificate of Completion by: Dave R Hunnicutt, RS date 4/13/95

Operation Permit by: date

HEALTH DEPT. COPY: WHITE INSPECTION COPY (FINAL): GREEN OWNER COPY (FINAL): YELLOW INSPECTION COPY (INITIAL): PINK OWNER COPY (INITIAL): GOLD