IREDELL COUNTY HEALTH DEPARTMENT

Statesville Office (704) 878-5305 Mooresville Office (704) 660-3625 PERMIT # 206443

IMPROVEMENT PERMIT / AUTHORIZATION TO CONSTRUCT / OPERATION PERMIT / EXISTING SYSTEM

PIN # 4648-32-0650

APPLICANT: JOE CUTRI APPLICANT ADDRESS: 745 SYRACUSE NY

SITE ADDRESS: 124 CHEROKEE DR. PHONE: 315-481-2845 ALT. PHONE:

SITE DIRECTIONS: BLUEFIELD, BIG INDIAN LOOP, CHEROKEE, ON R

SUBDIVISION: BEARSFOOT BAY SECTION: LOT # 6 LOT AREA: DESIGN FLOW: 360 L.T.A.R.: .3

Septic Tank	1000 (gal)	STB	794	Date	5-11-15	☒ New System	☐ Repair	☐ Expansion	System Type: I II (III) IV V VI
Pump Tank	1000 (gal)	PT	283	Date	5-6-15	System Description:	PM - PANEL BLOCK		
Pump Make	MYERS	Model	ME 45	Serial #		Repair System Description:	LP - PANEL BLOCK		
# Nitrification Fields	1	# Lines	4 C 50'	Linear Ft:	200'	Maintenance Agreement Required:	☐ YES	☒ NO	
Trench Width	24"	Max. Trench Bottom Depth	36"	Gravel Depth			☐ GRAVITY	☒ PRESSURE	

☒ Residence ☐ Business ☐ Other ☐ Slab ☐ Basement w/plumbing

No. Bedrooms 3 No. Persons No. Employees ☒ Crawl Space ☐ Basement w/o plumbing


Water Supply: ☒ Private ☐ Public ☐ Community

Comments / Conditions: HOUSE SHIFTED TOWARD REAR OF LOT 25' MORE TANKS COULD GO IN FRONT OF HOUSE (STREET SIDE) AND WELL MOVED CLOSER TO HOUSE.


6/23/15 ST - 15ft from House, PT - 10ft 6" to PL

6/24/15 Drain lines checked

INITIAL SITE SKETCH

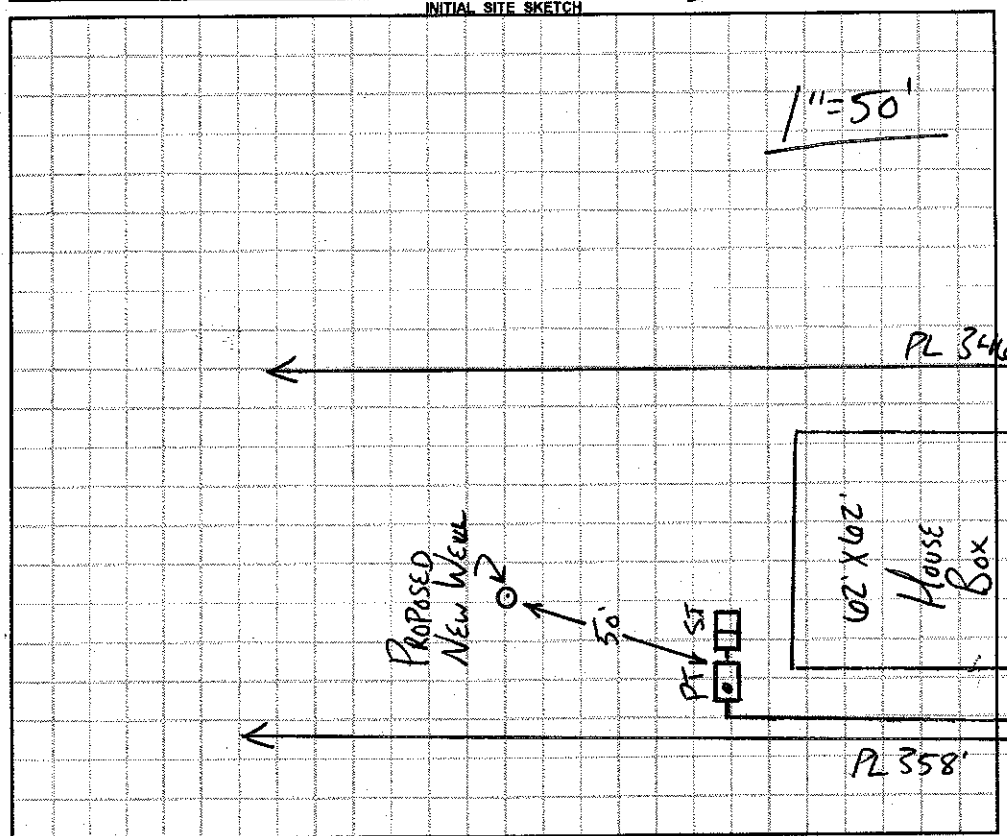

AS BUILT SKETCH

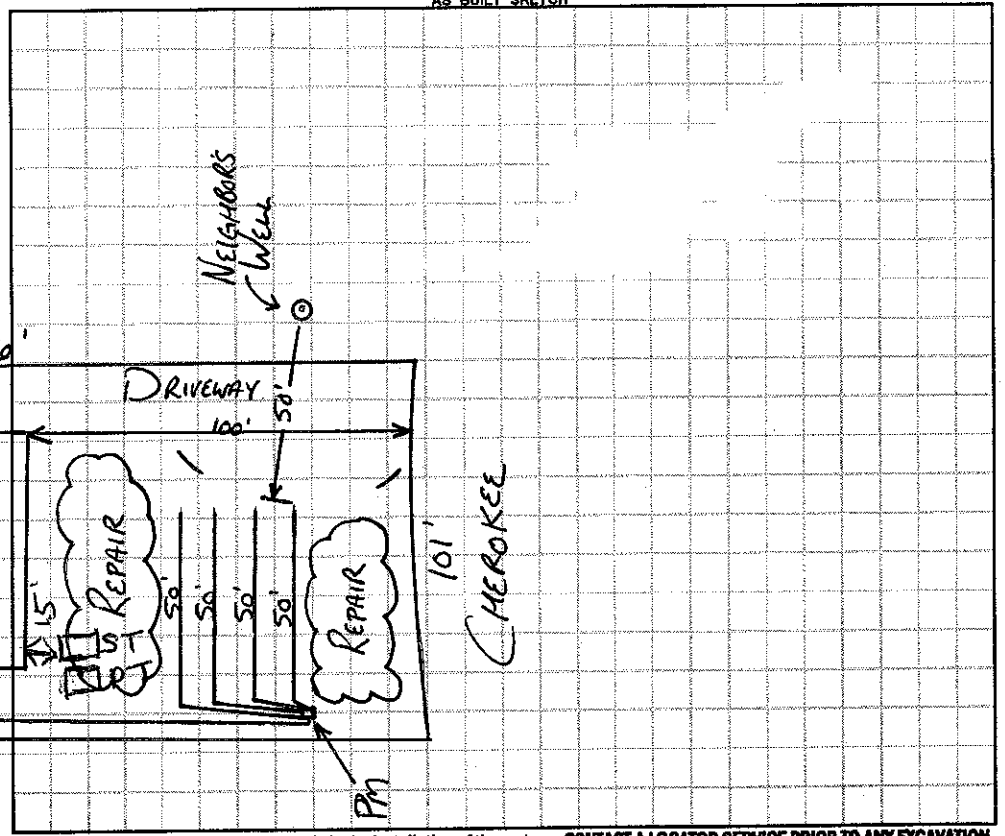

Permit can be suspended or revoked if any false information is supplied toward securing the permit / any unauthorized changes are made to the site / any unauthorized changes are made in the installation of the system. **CONTACT A LOCATOR SERVICE PRIOR TO ANY EXCAVATION**

☐ **IMPROVEMENT PERMIT** *with plat valid without expiration.* ☒ **IMPROVEMENT PERMIT** *with site plan valid for 60 mos.* ☒ **AUTHORIZATION TO CONSTRUCT** *valid for period equal to IMPROVEMENT PERMIT--not to exceed 60 mo.*

Owner / Applicant Signature: Kelly Chappell Date: 1/27/2015 Installed by: Specialty Septic

IMPROVEMENT PERMIT by: APPROVED Date: JAN 15 2014 OPERATION PERMIT by: APPROVED Date: JUL 10 2015

AUTHORIZATION TO CONSTRUCT by: APPROVED Date: JAN 15 2014 Existing System Inspected by: Date:

Health Dept. Copy - WHITE Applicant (Final Approval) - YELLOW Applicant (Conditional Approval) - PINK