1:45

IREDELL COUNTY HEALTH DEPARTMENT

STATESVILLE 704-878-5305 MOORESVILLE 704-664-5281

IMPROVEMENT PERMIT / AUTHORIZATION TO CONSTRUCT / OPERATION PERMIT / EXISTING SYSTEM INSPECTION

PERMIT# 970477 PIN# 4648320870 DATE 6/25/98

OWNER OR CONTRACTOR Kenny Traynor PHONE: Business (704) 663-3657 Home ~~Pg~~ 514-4626

ADDRESS 281 Big Indian Loop Mooresville NC 28115

LOCATION Hwy 150 TR Bluefield Rd TL Big Indian Loop TL Cherokee 2nd property on right

SUBDIVISION Bears Lot Pay BLOCK / SECTION LOT 4 LOT AREA SITE CLASS. PS DESIGN FLOW 360gpd L.T.A.R. .3

Septic Tank: 1000 Gallons; STB 794 Date 4-22-98

Pump Tank: 1000 Gallons; PT 27 Date 5-22-98

Pump Make: Zoeller Model E04411A Serial No. 12/5/97

Nitrification Field: No Fields 1 Square Feet ~~900~~ Linear Feet ~~900~~

No Lines 5 at 60' Trench Width 36" Max Trench Bottom Depth 36" Gravel Depth N/A

☒ New System ☐ Repair System Type: I, II, III, IV, V, VI

System Description: Pump (pm) - Pl. Chamber or Similar

Repair System Description: Same

Maintenance Agreement Required: ☐ Yes ☒ No

☒ House/Mod. Home No. Bedrooms 3

☐ Mobile Home No. Bathrooms 2.5

☐ Business No. Employees

☐ Other

☐ Slab ☒ Crawl Space ☐ Basement w/plumbing ☐ Basement wo/plumbing

Water Supply: ☒ Individual ☐ Public ☐ Community


Comments:/Conditions: Keep Septic System 5' from House & 10' from PL Va 50'± from well
A 25% Reduction in Drainfield

Comments:/Conditions:


SEE M97/6916

INITIAL SITE SKETCH

Scale 1:60

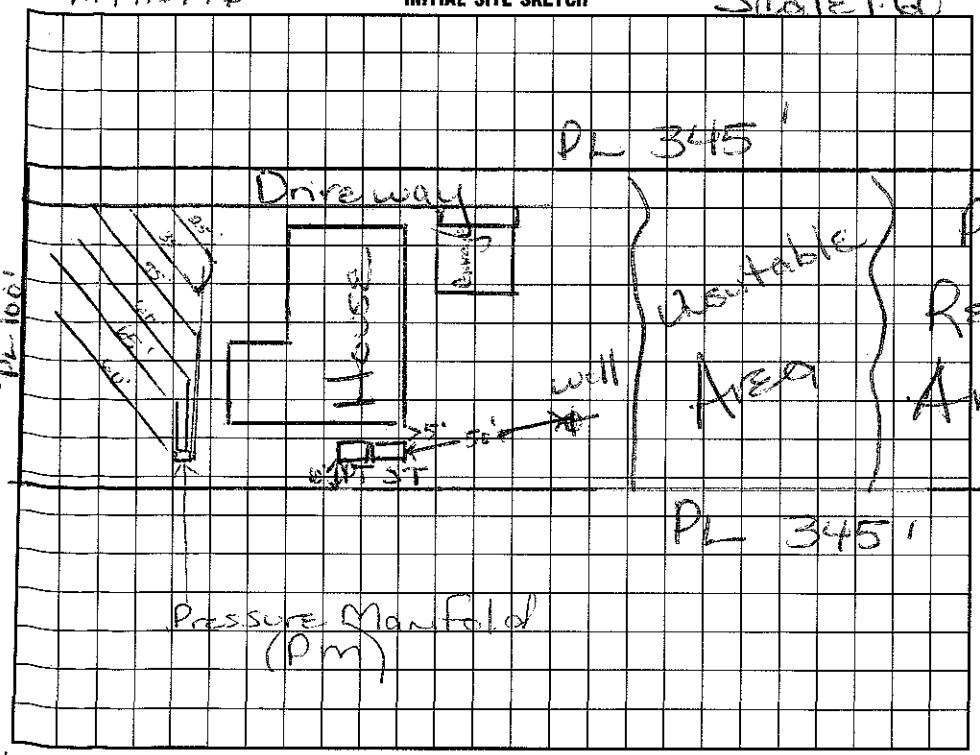

AS BUILT SKETCH

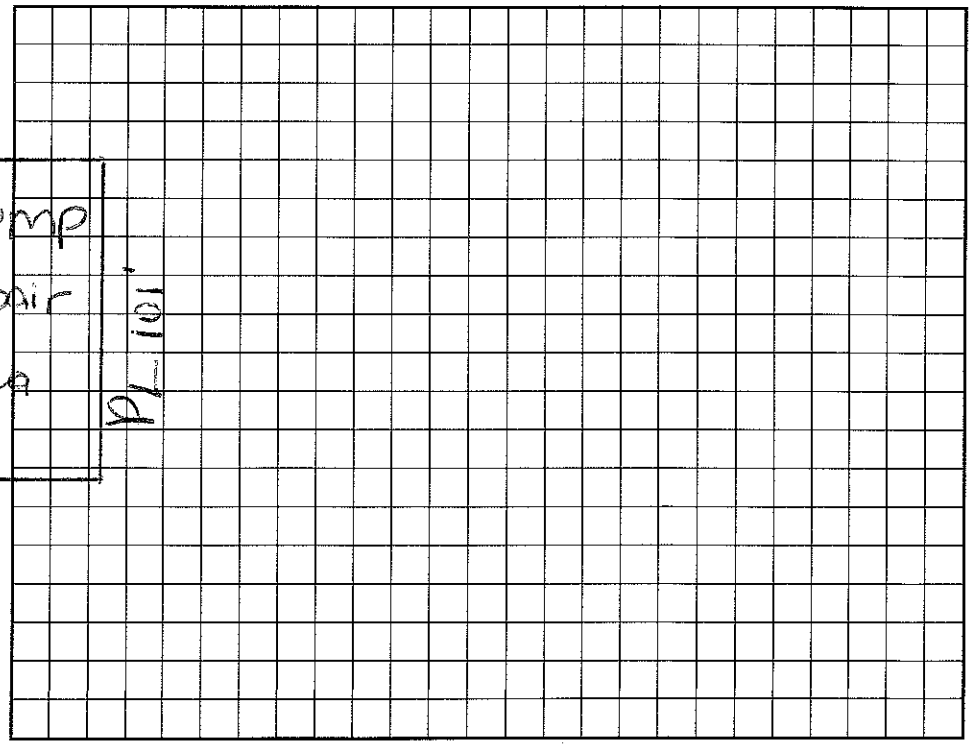

I understand that this permit can be suspended or revoked if any false information is supplied toward securing the permit/any unauthorized changes are made to the site/any unauthorized changes are made in the installation of the system. Improvement Permit with plat valid without expiration. Improvement Permit with site plan valid for sixty months. Authorization to Construct is valid for a period equal to that of Improvement Permit – not to exceed sixty months.

Signed: Kenny Traynor date 6/26/98 Installed by: Curt Dunning

Improvement Permit by: Marvin H. Watson date 6/25/98 Operation Permit by: [signature] date 7/28/98

Authorization to Construct by: Marvin H. Watson date 6/25/98 Existing System Inspection by: date

HEALTH DEPT. COPY: WHITE INSPECTION COPY (FINAL): GREEN OWNER COPY (FINAL): YELLOW INSPECTION COPY (INITIAL): PINK OWNER COPY (INITIAL): GOLD