IREDELL COUNTY HEALTH DEPARTMENT

STATESVILLE 704-878-5305 4648-32-3020 MOORESVILLE 704-664-5281

IMPROVEMENT PERMIT / CERTIFICATE OF COMPLETION / OPERATION PERMIT / EXISTING SYSTEM INSPECTION

PROPERTY DESCRIPTION NO. 17357 DATE 10/27/93 TAX MAP NO. 2P10A19 Watershed: ☑ Yes ☐ No

OWNER OR CONTRACTOR ERIC FRYE PHONE: Business 568-1816 (LISA) Home

ADDRESS 1200 KELSTON PL APT 108 CHARLOTTE, NC. 28212

LOCATION CHEROKEE DR. BLUE WING TL BIG INDIAN LP, TL ON CHEROKEE, 1ST ON (L) AFTER BOAT ACCESS

SUBDIVISION BEARS FOOT BAY BLOCK / SECTION LOT 19 LOT AREA .732 SITE CLASS. P DESIGN FLOW 360 L.T.A.R. .3-.35

Septic Tank: 1000 Gallons; STB 794 Date 7/1/94

Pump Tank: 1000 Gallons; PT 27 Date 7/1/94

Pump Make: Model Serial No.

Nitrification Field: No Fields 1 Square Feet 1200 Linear Feet 400

No Lines 4 Trench Width 3' Max Trench Bottom Depth 36" Gravel Depth 12"

☐ New System ☐ Repair System Type: I, II, III, IV, V, VI

System Description: PRES-CONV - LPP DIST

Repair System Description: " " "

Maintenance Agreement Required: ☑ Yes ☐ No

☑ House/Mod. Home No. Bedrooms 3

☐ Mobile Home No. Bathrooms 2

☐ Business No. Employees

☐ Other 1½


☐ Slab ☑ Crawl Space ☐ Basement w/plumbing ☑ Basement wo/plumbing

Water Supply: ☑ Individual ☐ Community ☐ Public

Comments: 2" PVC - 3/16" HOLE ON 5 FT. CNTRS, 2' STANDPIPE AT END OF EACH LATERAL.

Comments: Pressure Manifold set at 2' TOH Drawn mounted in gravel Installed essentially as drawn on Imp. Permit

INITIAL SITE SKETCH

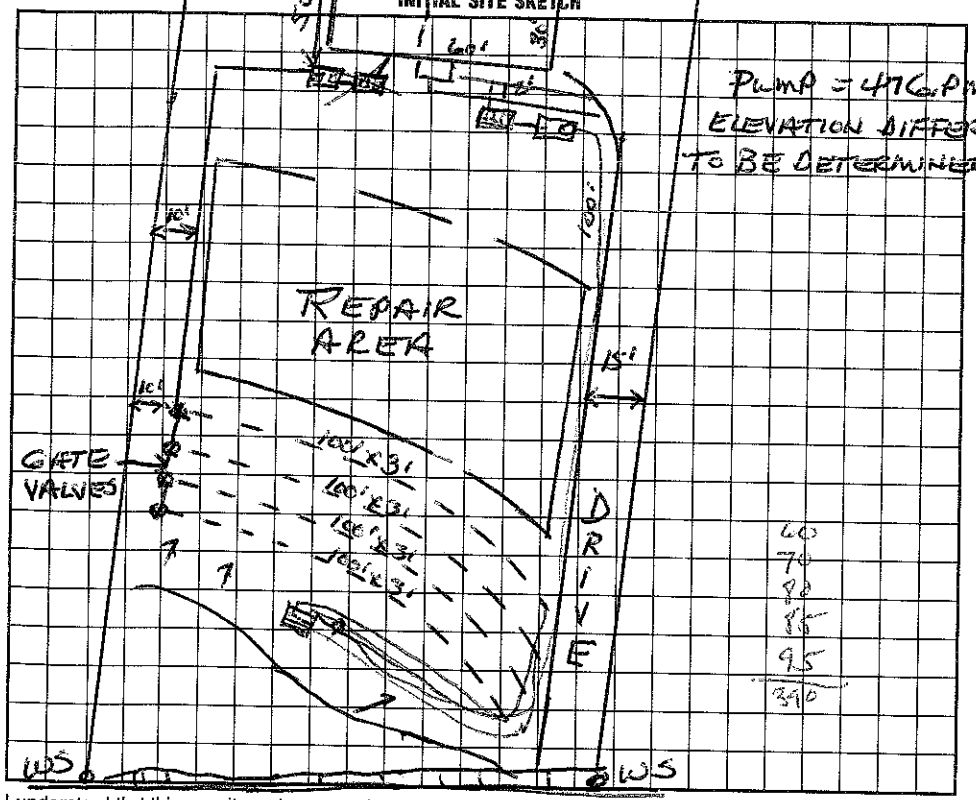

PUMP = 47 G.P.M.
ELEVATION DIFFERENCE TO BE DETERMINED

60
70
80
85
95
390

AS BUILT SKETCH

I understand that this permit can be suspended or revoked if any false information is supplied toward securing the permit/any unauthorized changes are made to the site/any unauthorized changes are made in the installation of the system. Improvement Permit is valid for 60 months from date of issuance.

Signed: Eric Frye 1 CHEROKEE DRIVE

Improvement Permit by: Wesley Sparks date 10/29/93

Existing System Inspection by: date

Installed by: Walter Barton

Certificate of Completion by: Wesley Sparks RS

Operation Permit by:

HEALTH DEPT. COPY: WHITE INSPECTION COPY (FINAL): GREEN OWNER COPY (FINAL): YELLOW INSPECTION COPY