IREDELL COUNTY HEALTH DEPARTMENT

AUTHORIZATION TO CONSTRUCT

STATESVILLE 704-878-5305 MOORESVILLE 704

IMPROVEMENT PERMIT / ~~CERTIFICATE OF COMPLETION~~ / OPERATION PERMIT / EXISTING SYSTE

PROPERTY DESCRIPTION NO. 069482 DATE 10/31/97 TAX MAP NO. 4048323447 Wate

OWNER OR CONTRACTOR ROBERT BOGGS PHONE: Business Home 704 428-8223

ADDRESS 1872 MAIDEN RD - MAIDEN NC 28650

LOCATION BLUE FIELD - TL BIG INDIAN LOOP - CORNER OF BIG INDIAN AND CHEROKEE.

SUBDIVISION BEARFOOT BAY BLOCK / SECTION LOT 27 LOT AREA - SITE CLASS. PS DESIGN FLOW 360 GPD L.T.A.R. 1.3 GPD/SQ FT

Septic Tank: 1000 Gallons; STB 299 Date 3/6/98

Pump Tank: Gallons; PT Date

Pump Make: Model Serial No.

Nitrification Field: No Fields 1 Square Feet 1200 Linear Feet 400

No Lines 4 @ 100' Trench Width 36" Max Trench Bottom Depth 36" Gravel Depth 12"

☑ New System ☐ Repair System Type: I (II) III, IV, V, VI

System Description: GRAVITY CONVENTIONAL

Repair System Description: CHAMBERED OR IDS

Maintenance Agreement Required: ☐ Yes ☑ No

☑ House/Mod. Home No. Bedrooms 3

☐ Mobile Home No. Bathrooms 2

☐ Business No. Employees

☐ Other

☐ Slab ☑ Crawl Space ☐ Basement w/plumbing ☐ Basement wo/plumbing


Water Supply: ☑ Individual ☐ Community ☐ Public

Comments:

Comments:

* SYSTEM WAS SATURATED HEAVILY BY RAIN WATER - LEAVING TRENCHES UNCOVERED OVER NIGHT * SOME SILT DEPOSITS IN UPPER TRENCH.

INITIAL SITE SKETCH

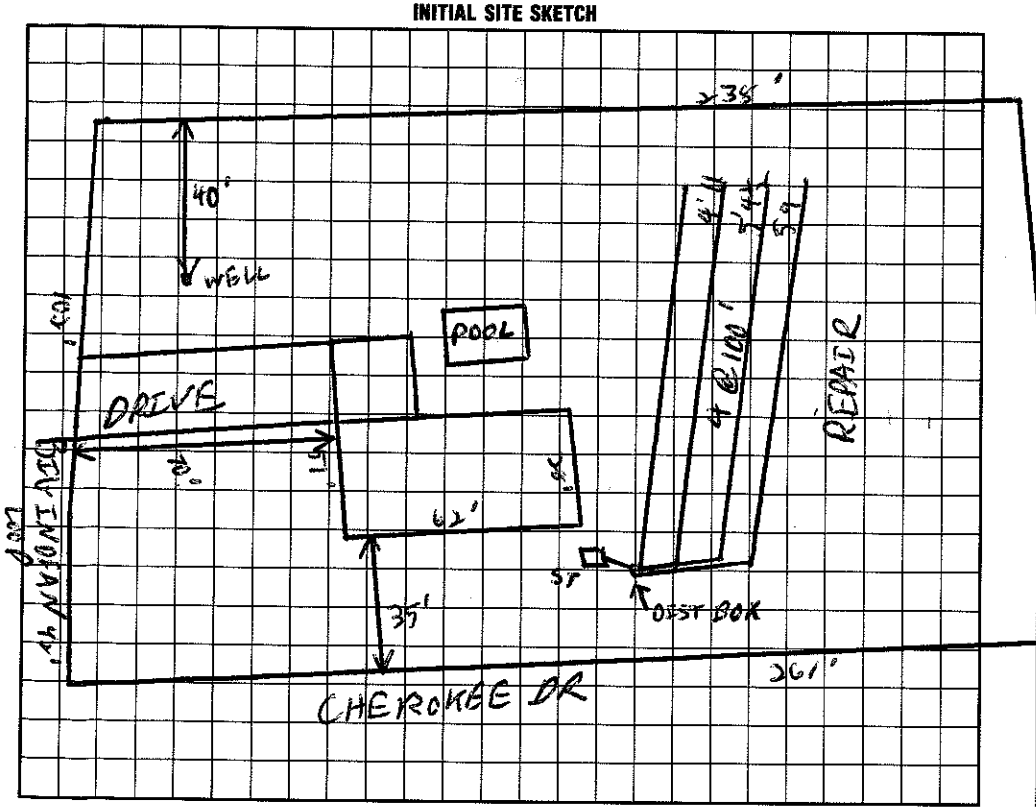

AS BUILT SKETCH

I understand that this permit can be suspended or revoked if any false information is supplied toward securing the permit/any unauthorized changes are made to the site/any unauthorized changes are made in the installation of the system. Improvement Permit is valid for 60 months from date of issuance.

Signed: Marsha W. Lifford

Improvement Permit by: C. M. Lifford RS date 10/31/97

AUTHORIZATION TO CONSTRUCT Existing System Inspection by: C. M. Lifford RS date 10/31/97

Installed by: CLAUDIUS MORRISON

Certificate of Completion by: date

Operation Permit by: C. M. Lifford RS date 5/29/98

HEALTH DEPT. COPY: WHITE INSPECTION COPY (FINAL): GREEN OWNER COPY (FINAL): YELLOW INSPECTION COPY (INITIAL): PINK OWNER COPY (INITIAL): GOLD