IREDELL COUNTY HEALTH DEPARTMENT

STATESVILLE 704-878-5305 MOORESVILLE 704-664-5281

IMPROVEMENT PERMIT / CERTIFICATE OF COMPLETION / OPERATION PERMIT / EXISTING SYSTEM INSPECTION

PROPERTY DESCRIPTION NO. 21957 DATE 9/1/95 TAX MAP NO. 2P 10A 21 4648 32 4249 Watershed: [X] Yes [ ] No

OWNER OR CONTRACTOR Billie D Hinton PHONE: Business _____ Home 394-3138

ADDRESS 5301 Pine Cone Dr. Charlotte, NC 28214

LOCATION Beaufort Bay - Byerlodian Lp. TL Chanokee Lot on (L) left before access road

SUBDIVISION Beaufort Bay BLOCK / SECTION _____ LOT 21 LOT AREA 1.18 AC SITE CLASS. PS DESIGN FLOW 360 L.T.A.R. .3

Septic Tank: 1000 Gallons; STB 794 Date 5-7-98

Pump Tank: 1000 Gallons; PT 27 Date 8-8-98

Pump Make: HYDROMATIC Model SHEF 50A1 Serial No. 8/98

Nitrification Field: No Fields 1 Square Feet 1200 Linear Feet *300

No Lines 4 Trench Width 36" Max Trench Bottom Depth 36" Gravel Depth 6" SAND

[X] New System [ ] Repair System Type: I, II, III, IV, V, VI

System Description: Pressure shallow trench

Repair System Description: Same

Maintenance Agreement Required: [X] Yes [ ] No

[X] House/Mod. Home No. Bedrooms 3

[ ] Mobile Home No. Bathrooms 2.5

[ ] Business No. Employees ____

[ ] Other ____


[ ] Slab [X] Crawl Space [ ] Basement w/plumbing [ ] Basement wo/plumbing

Water Supply: [X] Individual [ ] Community [ ] Public


Comments: *25% reduction for shallow trench use
4 @ 75' x 3' shallow trench lines
Gate valve in wash box required - Speed levelers in distribution Box

Comments: 300 ÷ 150 = 2 bedroom -

INITIAL SITE SKETCH

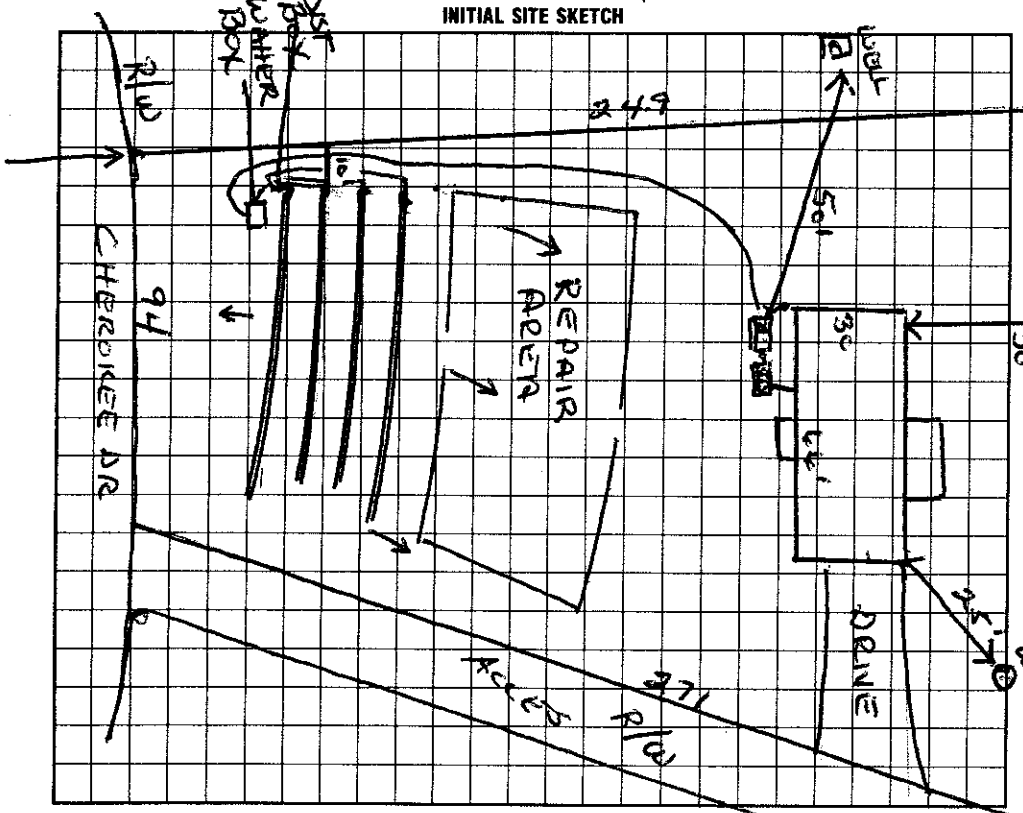

AS BUILT SKETCH

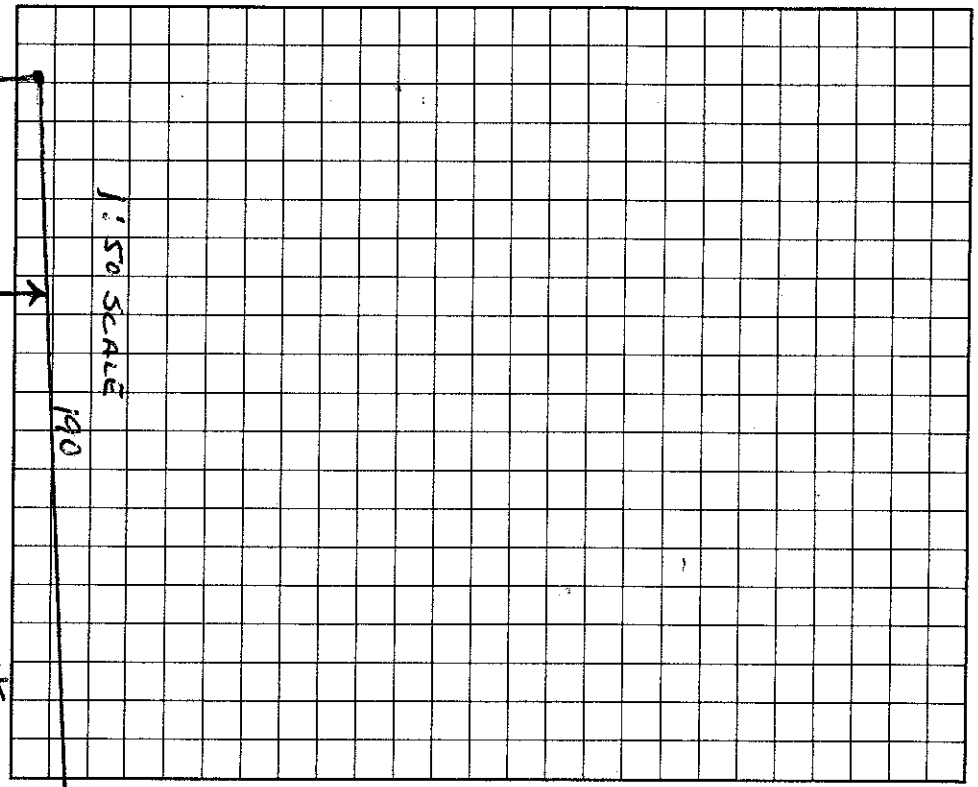

I understand that this permit can be suspended or revoked if any false information is supplied toward securing the permit/any unauthorized changes are made to the site/any unauthorized changes are made in the installation of the system.

Signed: x Angela R. Craig

Improvement Permit by: Wesley Sparks date _____

Existing System Inspection by: _____ date _____

Installed by: Willie Christenbury

Certificate of Completion by: _____ date _____

Operation Permit by: Wesley Sparks R.S. date 10/7/98

HEALTH DEPT. COPY: WHITE INSPECTION COPY (FINAL): GREEN OWNER COPY (FINAL): YELLOW INSPECTION COPY (INITIAL): PINK OWNER COPY (INITIAL): GOLD