IREDELL COUNTY HEALTH DEPARTMENT

STATESVILLE 704-878-5305 MOORESVILLE 704-664-5281

IMPROVEMENT PERMIT / AUTHORIZATION TO CONSTRUCT / OPERATION PERMIT / EXISTING SYSTEM INSPECTION

PERMIT # 153325 PIN # 4648324249 DATE 10/30/08

OWNER or APPLICANT James McNeill PHONE: Business 704.677.2881 Home: 704.799.2101

OWNER or APPLICANT ADDRESS 159 Walmsley Pl Mooresville, NC 28117

LOCATION / DIRECTIONS 139 Cherokee Dr, 150 W, TR Bluefield, TL Big Indian, TL Cherokee, on left

SUBDIVISION Bearsfoot Bay BLOCK / SECTION — LOT # 21 LOT AREA 1.18Ac DESIGN FLOW 360 L.T.A.R. 0.3

Septic Tank 1000 exist Gallons: STB 794 Date 5-7-98
Pump Tank 1000 exist Gallons: P.T 27 Date 8-8-98
Pump Make Hydromatic Model Shef 50A1 Serial # 8/98
Nitrification Field No Fields 1 No Lines 4 Linear Feet 300
Trench Width 36" Max. Trench Bottom Depth 36" Gravel Depth —

☐ New System ☐ Repair ☐ Expansion System Type I II III IV V VI
System Description: existing Pump 25%
Repair System Description: Pump 25%
Maintenance Agreement Required ☐ YES ☒ NO
☐ GRAVITY ☒ PRESSURE


☒ Residence No. Bedrooms 3
☐ Business No. Persons
☐ Other No. Employees
☐ Slab ☐ Crawl Space
☒ Basement w/plumbing ☐ Basement w/o plumbing

Water Supply: ☒ Private ☐ Public ☐ Community

Comments / Conditions — Addition will not affect Septic System or tanks

Comments / Conditions

INITIAL SITE SKETCH

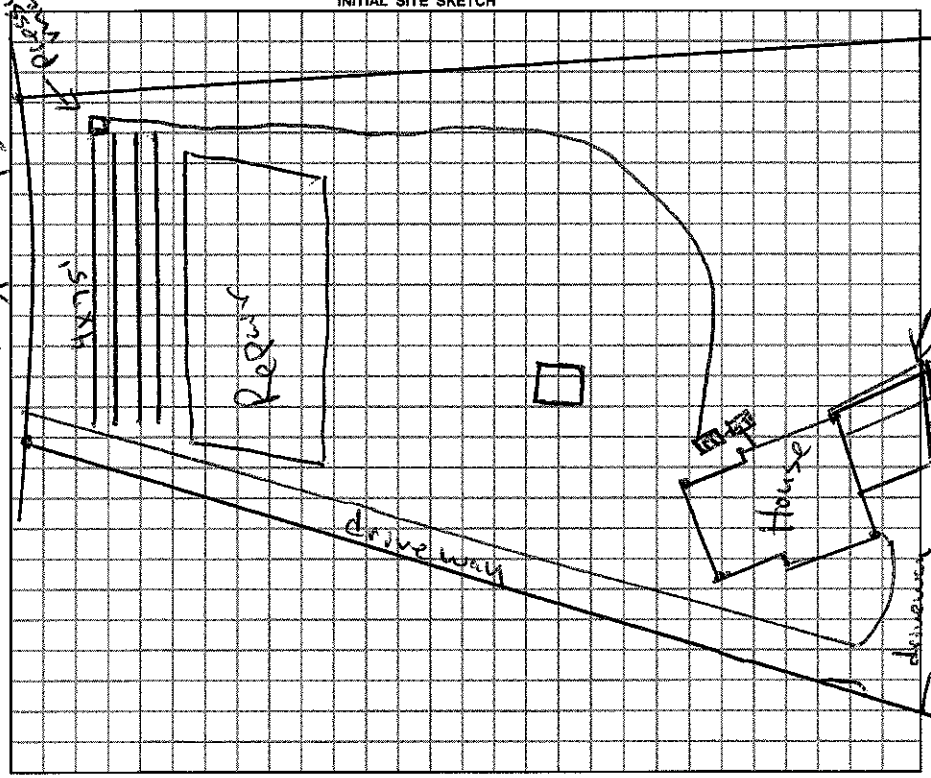

AS BUILT SKETCH

Permit can be suspended or revoked if any false information is supplied toward securing the permit / any unauthorized changes are made to the site / any unauthorized changes are made in the installation of the system.

☐ *IMPROVEMENT PERMIT w / plat valid without expiration.* ☐ *IMPROVEMENT PERMIT w / site plan valid for 60 mos.* ☐ *AUTHORIZATION TO CONSTRUCT valid for period equal to IMPROVEMENT PERMIT-not to exceed 60 mo.*

Owner / Applicant Signature: James N. McNeill Date 10/31/08

Improvement Permit by: Date

Authorization to Construct by: Date

YOU SHOULD CONTACT A LOCATOR SERVICE PRIOR TO ANY EXCAVATION.

Installed by:

Operation Permit by: Date:

Existing System Inspected by: Randy Nunn Date: 10/30/08

WHITE COPY Environmental Health YELLOW COPY (Final) Owner / Applicant PINK COPY (Initial) Owner / Applicant