IREDELL COUNTY HEALTH DEPARTMENT

AUTHORIZATION TO CONSTRUCT

STATESVILLE 704-878-5305 MOORESVILLE 704-664-5281

IMPROVEMENT PERMIT / ~~CERTIFICATE OF COMPLETION~~ / OPERATION PERMIT / EXISTING SYSTEM INSPECTION

PROPERTY DESCRIPTION NO. 24305 DATE 8/14/96 TAX MAP NO. 2P-16-A-23 Watershed: ☑ Yes ☐ No

OWNER OR CONTRACTOR OSCAR KOEHLER PHONE: Business _____ Home 662-0185

ADDRESS 102 COBBLESTINE LN. MOORESVILLE NC 28115

LOCATION BLUEFIELD- TL BIG INDIAN LOOP- TL CHEROKEE OR LOT ON LT.

SUBDIVISION Bears Bay BLOCK / SECTION _____ LOT 23 LOT AREA _____ SITE CLASS. RS DESIGN FLOW 360 L.T.A.R. .3

Septic Tank: 1000 Gallons; STB _____ Date _____

Pump Tank: 1000 Gallons; PT _____ Date _____

Pump Make: _____ Model _____ Serial No. _____

Nitrification Field: No Fields 1 Square Feet 1200 Linear Feet 400

No Lines 5 Trench Width 36" Max Trench Bottom Depth 36" Gravel Depth 12"

☑ New System ☐ Repair System Type: I, II, (III), IV, V, VI

System Description: ~~CONV.~~ PUMP CONV.

Repair System Description: PUMP CHAMBERED

Maintenance Agreement Required: ☐ Yes ☑ No

☑ House/Mod. Home No. Bedrooms 3

☐ Mobile Home No. Bathrooms 2

☐ Business No. Employees _____

☐ Other _____


☐ Slab ☑ Crawl Space ☐ Basement w/plumbing ☐ Basement wo/plumbing

Water Supply: ☑ Individual ☐ Community ☐ Public


Comments:

Comments:

INITIAL SITE SKETCH 1150 ~~H=60'~~

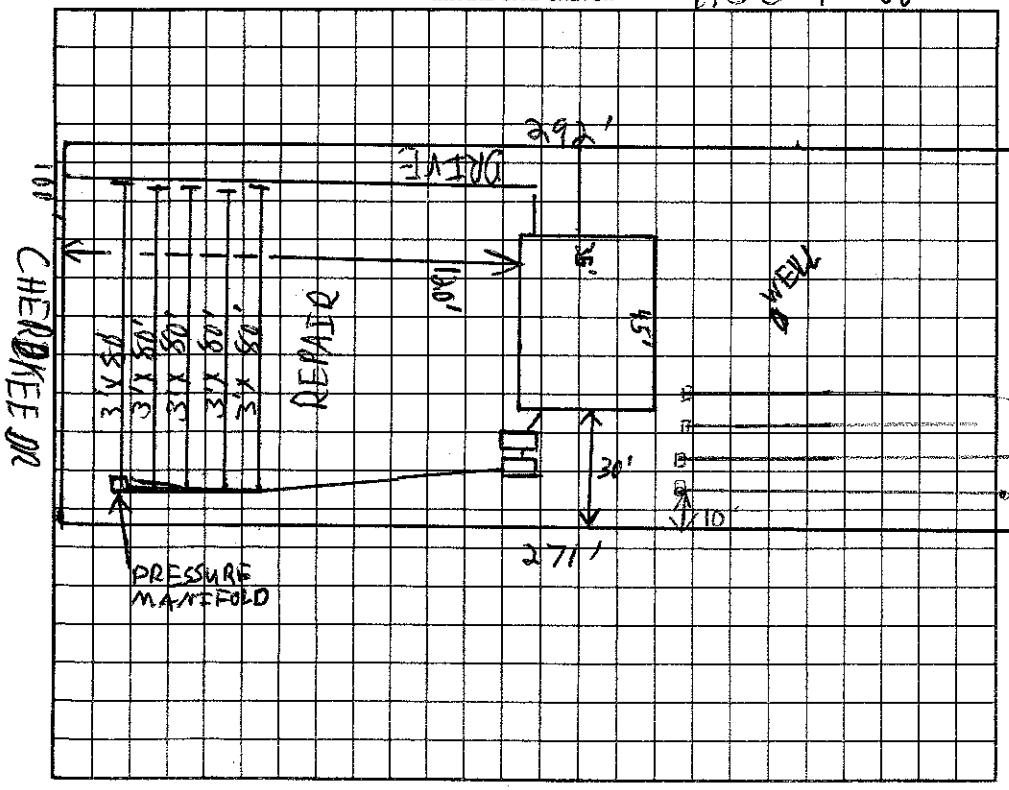

AS BUILT SKETCH

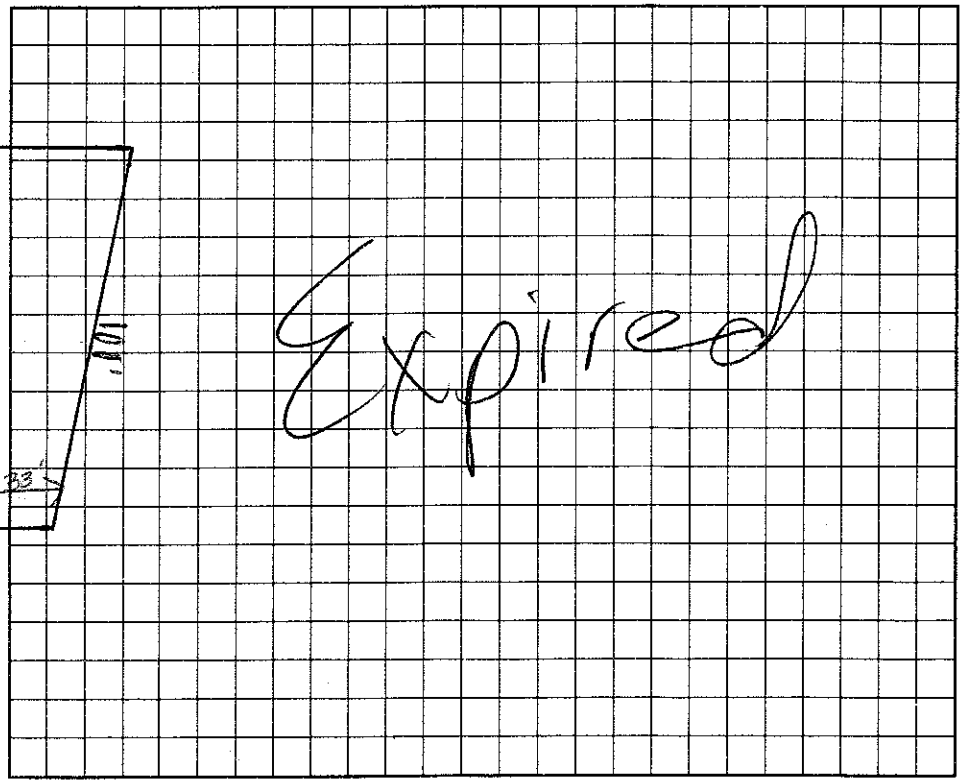

I understand that this permit can be suspended or revoked if any false information is supplied toward securing the permit/any unauthorized changes are made to the site/any unauthorized changes are made in the installation of the system.

Signed: Debra Koehler 2-25-96

Improvement Permit by: C. Blythe EHSI date 8/14/96

AUTHORIZATION TO CONSTRUCT Existing System Inspection by: C. Blythe EHSI date 8/14/96

Installed by: _____

Certificate of Completion by: _____ date _____

Operation Permit by: _____ date _____

HEALTH DEPT. COPY: WHITE INSPECTION COPY (FINAL): GREEN OWNER COPY (FINAL): YELLOW INSPECTION COPY (INITIAL): PINK OWNER COPY (INITIAL): GOLD

AUTHORIZATION TO CONSTRUCT IS VALID FOR 60 MONTHS FROM ISSUE DATE. IMPROVEMENTS PERMIT EXPIRES IN 60 MONTHS.