IREDELL COUNTY HEALTH DEPARTMENT

STATESVILLE 704-878-5305 MOORESVILLE 704-664-5281

IMPROVEMENT PERMIT / AUTHORIZATION TO CONSTRUCT / OPERATION PERMIT / EXISTING SYSTEM INSPECTION

PERMIT# 117867 PIN# 4648-32-8497.15 4648-32-6653 DATE March 9, 2004

OWNER OR CONTRACTOR Iredell Three LLC / ANATH=IM HOMES PHONE: Business Home

ADDRESS 6000 Old Pineville Rd. Charlotte, N.C. 28217

LOCATION 150 West TR Bluefield TL Big Indian Loop TL Cedar Woods 3rd lot on Right

SUBDIVISION Cedar Woods BLOCK / SECTION LOT 15 LOT AREA .60 Ac SITE CLASS. PS DESIGN FLOW 360gpd L.T.A.R. .25-.3

Septic Tank: 1000 Gallons; STB 1012 Date 6/11/05

Pump Tank: 1000 Gallons; PT 17 Date 7/6/05

Pump Make: Goulds Model WE0511H Serial No.

Nitrification Field: No Fields 1 Square Feet 480 Linear Feet 240

No Lines 4 Trench Width 24" MIN 86" Max Trench Bottom Depth 36" Gravel Depth NA

☑ New System ☐ Repair System Type: I, II, III, ⓘ V, VI

System Description: LPPPBRS

Repair System Description: LPPPBRS

Maintenance Agreement Required: ☑ Yes ☐ No

☑ House/Mod. Home No. Bedrooms 3

☐ Mobile Home No. Bathrooms 3

☐ Business No. Employees

☐ Other


☐ Slab ☑ Crawl Space ☐ Basement w/plumbing ☐ Basement wo/plumbing

Water Supply: ☑ Individual ☐ Public ☐ Community

Comments:/Conditions: CHECK FOR FIXED WINDOWS @ O.P.

Comments:/Conditions: 56 Panels 3/16"

1"=50' INITIAL SITE SKETCH

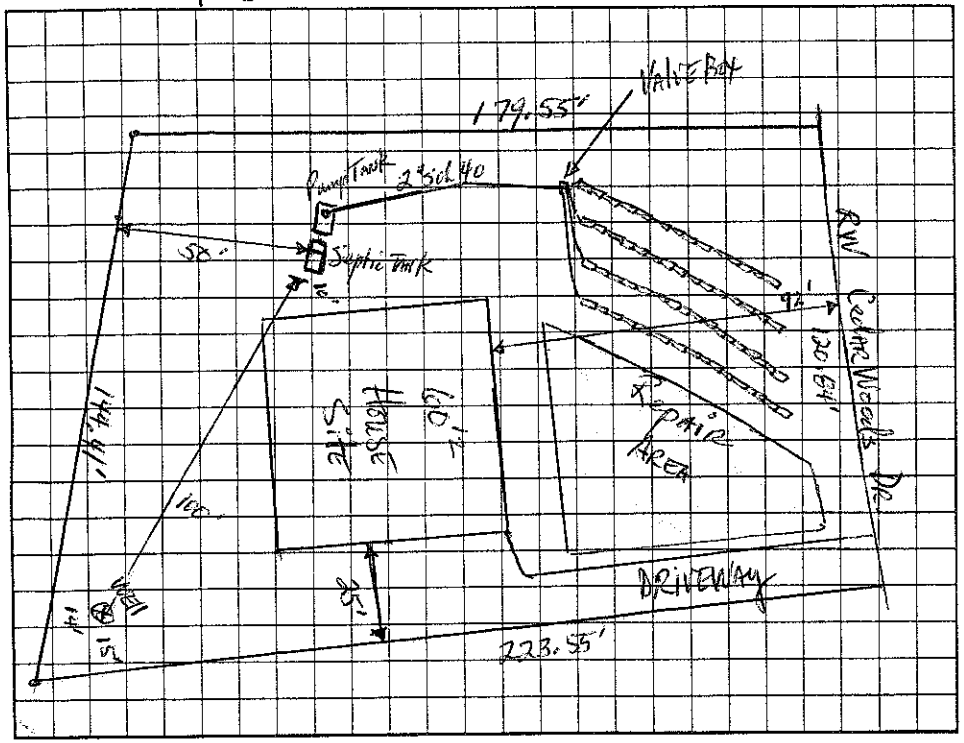

AS BUILT SKETCH

Permit can be suspended or revoked if any false information is supplied toward securing the permit/any unauthorized changes are made to the site/any unauthorized changes are made in the installation of the system. Improvement Permit with plat valid without expiration. Improvement Permit with site plan valid for sixty months. Authorization to Construct is valid for a period equal to that of Improvement Permit – not to exceed sixty months.

Signed: date 3/12/04 Installed by: C+S

Improvement Permit by: PS date 3-9-04 Operation Permit by: RS date 3/8/06

Authorization to Construct by: RS date 3/23/05 Existing System Inspection by: date

HEALTH DEPT. COPY: WHITE OWNER COPY (FINAL): YELLOW OWNER COPY (INITIAL): PINK