50.00 T9.4

IREDELL COUNTY HEALTH DEPARTMENT

STATESVILLE 704-878-5305 MOORESVILLE 704-664-5281

IMPROVEMENT PERMIT / AUTHORIZATION TO CONSTRUCT / OPERATION PERMIT / EXISTING SYSTEM INSPECTION

PERMIT# 118517 PIN# 4648 32 8497.12 4648-32-7322 DATE 1/24/05

OWNER OR CONTRACTOR Anaheim Homes PHONE: Business 704-909-9250 Home

ADDRESS PO Box 610 Cornelius, NC. 28031

LOCATION 150W TR Bluefield TL Big Indian TL Cedar Woods Dr. on (R) near end.

SUBDIVISION Cedar Woods BLOCK / SECTION LOT ~~14~~ 12 LOT AREA ~.75 SITE CLASS. PS DESIGN FLOW 360 L.T.A.R. .25-.3

Septic Tank: 1000 Gallons; STB 794 Date 12/12/04
Pump Tank: 1000 Gallons; PT 283 Date 10/22/04
Pump Make: Liberty Model ½ hp Serial No.
Nitrification Field: No Fields 1 Square Feet 440 Linear Feet 220
No Lines 4@55' Trench Width 24" Max Trench Bottom Depth 36" Gravel Depth —

☒ New System ☐ Repair System Type: I, II, III, (IV), V, VI
System Description: Pres Dosed - 16" PPBPS
Repair System Description: Same Type
Maintenance Agreement Required: ☒ Yes ☐ No
☐ Slab ☒ Crawl Space ☐ Basement w/plumbing ☐ Basement wo/plumbing


☒ House/Mod. Home No. Bedrooms 3
☐ Mobile Home No. Bathrooms 3
☐ Business No. Employees
☐ Other

Water Supply:
☒ Individual
☐ Public
☐ Community

Comments:/Conditions:
Syntec Filter Installed

Comments:/Conditions:

INITIAL SITE SKETCH AS BUILT SKETCH

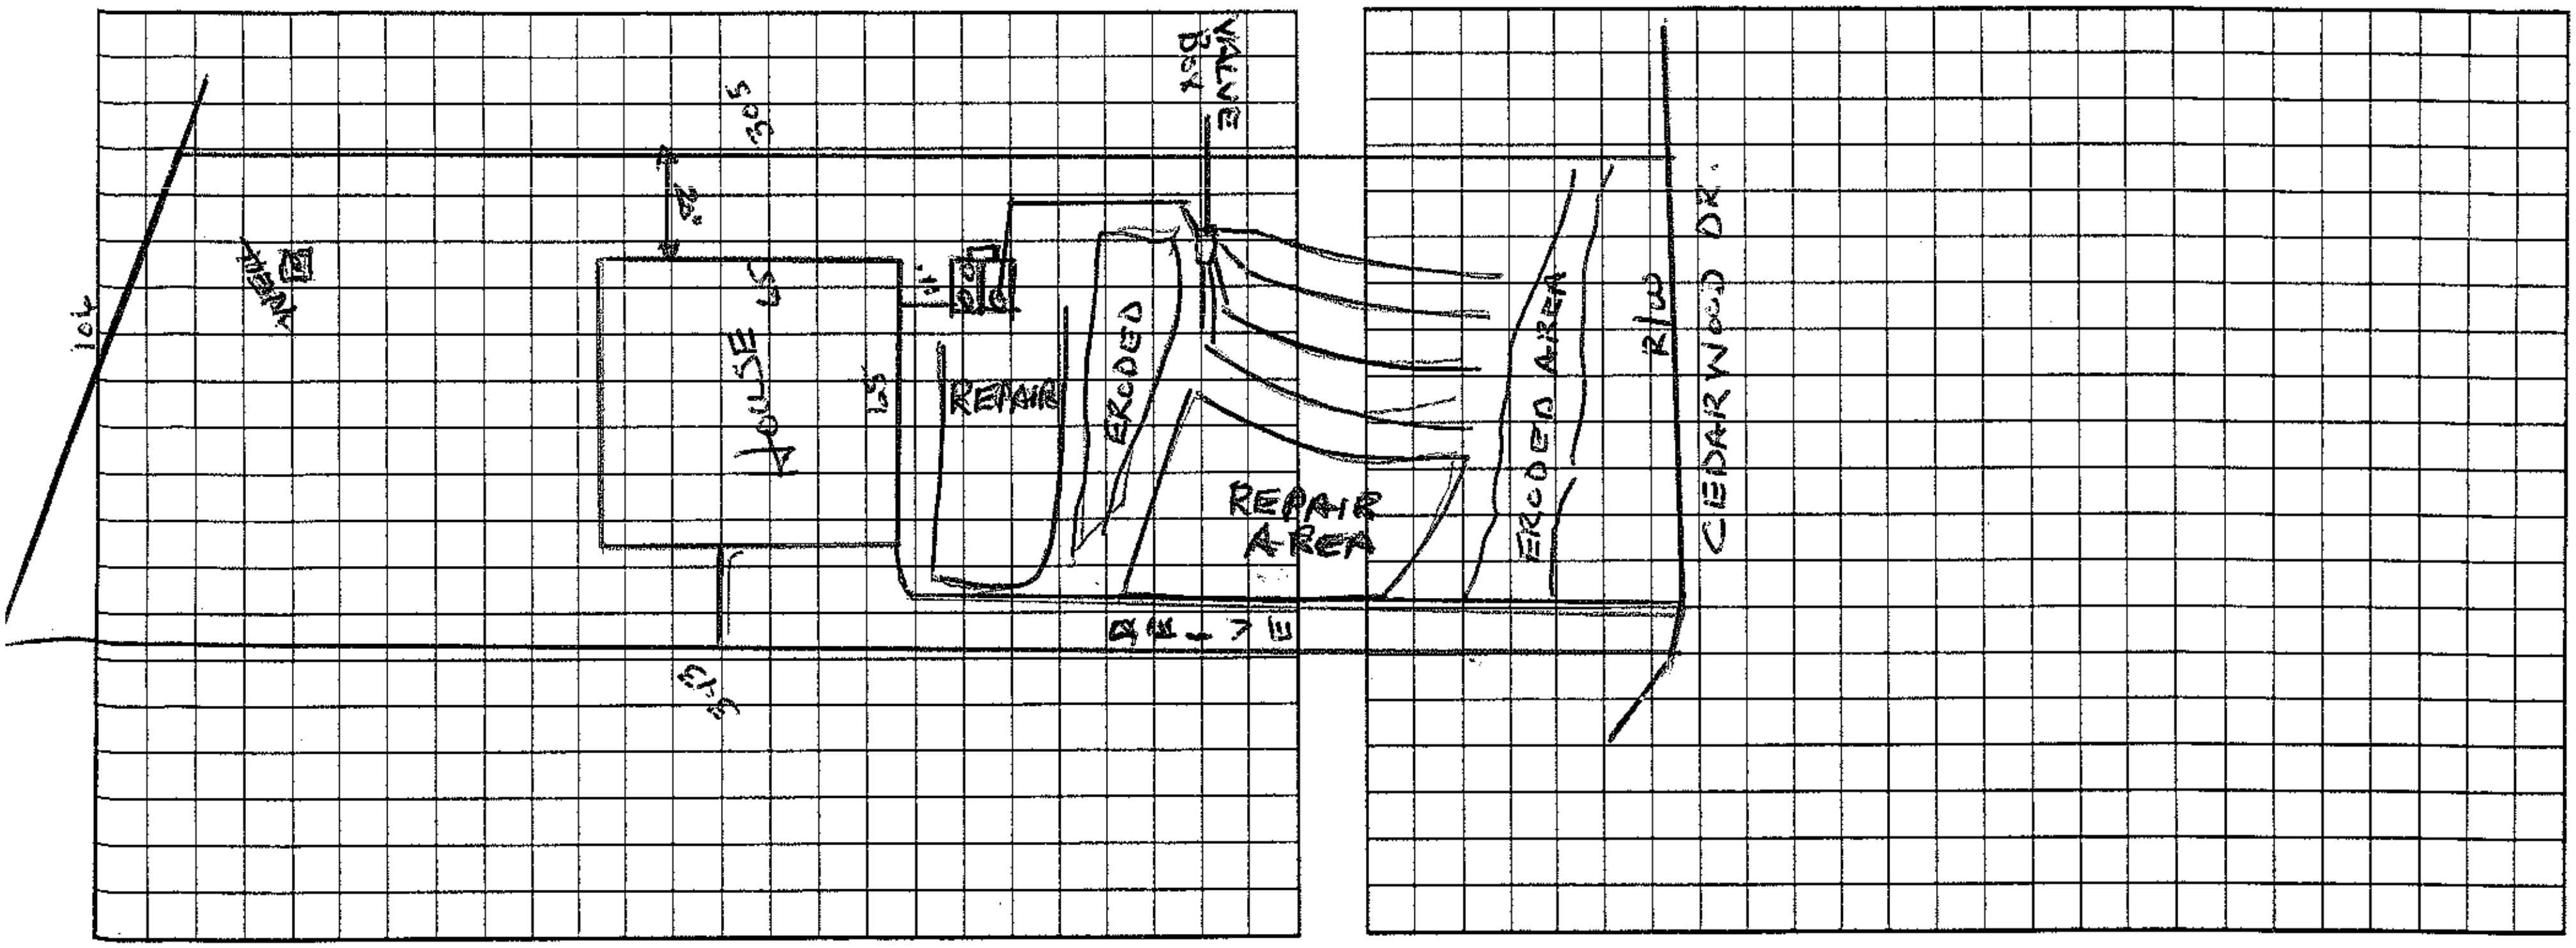

Permit can be suspended or revoked if any false information is supplied toward securing the permit/any unauthorized changes are made to the site/any unauthorized changes are made in the installation of the system. Improvement Permit with plat valid without expiration. Improvement Permit with site plan valid for sixty months. Authorization to Construct is valid for a period equal to that of Improvement Permit – not to exceed sixty months.

Signed: [signature] date 1/26/05 Installed by: Mark Jackson

Improvement Permit by: Wesley Sparks R.S. date 1/24/05 Operation Permit by: [signature] RS date 2/23/05

Authorization to Construct by: Wesley Sparks R.S. date 1/24/05 Existing System Inspection by: date

HEALTH DEPT. COPY: WHITE OWNER COPY (FINAL): YELLOW OWNER COPY (INITIAL): PINK