IREDELL COUNTY HEALTH DEPARTMENT

STATESVILLE 704-878-5305 — MOORESVILLE 704-664-5281

IMPROVEMENT PERMIT / AUTHORIZATION TO CONSTRUCT / OPERATION PERMIT / EXISTING SYSTEM INSPECT.

1100.00 Paid

PERMIT# 117825 PIN# 4648-32-8497.1 4648 32 8914 DATE August 11, 04

OWNER OR CONTRACTOR Iredell Three, LLC PHONE: Business _____ Home _____

ADDRESS 6000 Old Pineville Rd, Charlotte, N.C. 28217 107 CEDARWOODS DR.

LOCATION 150W JR Bluefield Rd. TL Big Indian Loop TL Cedarwoods DR. 1st lot on left

SUBDIVISION Cedarwoods BLOCK / SECTION _____ LOT 1 LOT AREA .67ac SITE CLASS. RS DESIGN FLOW 440gpd L.T.A.R. .035

Septic Tank: 1000 Gallons; STB 794 Date 11-2-04

Pump Tank: 1000 Gallons; PT 283 Date 12-28-04

Pump Make Little Giant Model# _____ Serial No. _____

Nitrification Field: No Fields 1 Square Feet 460 Linear Feet 230

No Lines 4 Trench Width 24" MIN B/04 Max Trench Bottom Depth 36" Gravel Depth N/A

☑ New System ☐ Repair System Type: I, II, III, (IV) V, VI

System Description: LP PPBPS

Repair System Description: LPPPBPS

Maintenance Agreement Required: ☑ Yes ☐ No

☑ House/Mod. Home No. Bedrooms 4

☐ Mobile Home No. Bathrooms _____

☐ Business No. Employees _____

☐ Other _____


☐ Slab ☑ Crawl Space ☐ Basement w/plumbing ☐ Basement wo/plumbing

Water Supply: ☑ Individual ☐ Public ☐ Community

Comments:/Conditions:

WELL must go EXACTLY where shown.

INITIAL SITE SKETCH

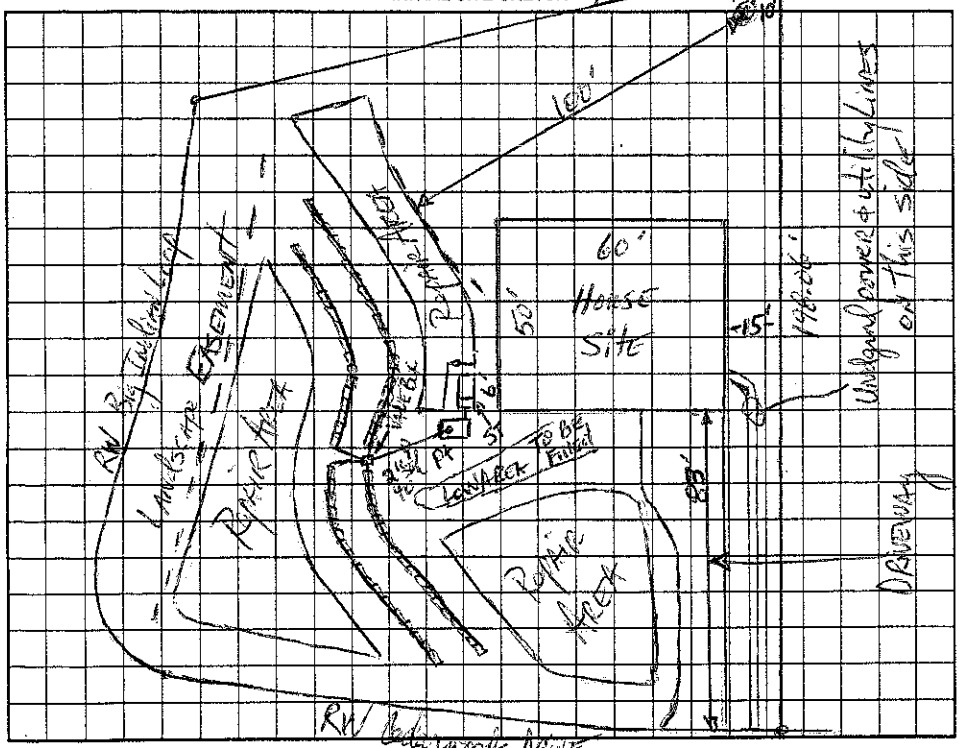

Comments:/Conditions:

Checked tanks & lines 2/23/05 MD

Maint. agreement attached 8/18/05

Pressure, select & alarm Checked by GM 8/17/05

AS BUILT SKETCH

Installed essentially as Drawn

Permit can be suspended or revoked if any false information is supplied toward securing the permit/any unauthorized changes are made to the site/any unauthorized changes are made in the installation of the system. Improvement Permit with plat valid without expiration. Improvement Permit with site plan valid for sixty months. Authorization to Construct is valid for a period equal to that of Improvement Permit – not to exceed sixty months.

Signed: _____ date 8/11/04 Installed by: Richard Abernathy

Improvement Permit by: DR Inman, RS date 8-11-04 Operation Permit by: Marvin H Dotson RS date 8/18/05

Authorization to Construct by: DR Inman, RS date 8-11-04 Existing System Inspection by: _____ date _____

HEALTH DEPT. COPY: WHITE OWNER COPY (FINAL): YELLOW OWNER COPY (INITIAL): PINK