IREDELL COUNTY HEALTH DEPARTMENT

4v4833 1692

STATESVILLE 704-878-5305 MOORESVILLE 704-664-5281

IMPROVEMENT PERMIT / CERTIFICATE OF COMPLETION / OPERATION PERMIT / EXISTING SYSTEM INSPECTION

PROPERTY DESCRIPTION NO. 088874 DATE 4/19/00 TAX MAP NO. #648 33 4343 Watershed: ☒ Yes ☐ No

OWNER OR CONTRACTOR James R. Collins PHONE: Business _____ Home 663-5946

ADDRESS 266 Big Indian Loop Mooresville NC 28117

LOCATION 150W TR Bluefield Rd, TL on Big Indian Loop, straight TR at 266 mailbox

SUBDIVISION No BLOCK / SECTION _____ LOT _____ LOT AREA ~2.85AC SITE CLASS. _____ DESIGN FLOW 240 L.T.A.R. _____

Septic Tank: Existing Gallons; STB _____ Date _____

Pump Tank: _____ Gallons; PT _____ Date _____

Pump Make: _____ Model _____ Serial No. _____

Nitrification Field: No Fields ~~3~~ Square Feet ~~System~~ Linear Feet _____

No Lines _____ Trench Width _____ Max Trench Bottom Depth _____ Gravel Depth _____

☐ New System ☐ Repair System Type: I, ☒ III, IV, V, VI

System Description: Existing System

Repair System Description: _____

Maintenance Agreement Required: ☐ Yes ☐ No

☐ House/Mod. Home No. Bedrooms 2

☒ Mobile Home No. Bathrooms 2

☐ Business No. Employees _____

☐ Other _____


☐ Slab ☐ Crawl Space ☐ Basement w/plumbing ☐ Basement wo/plumbing

Water Supply:
☒ Individual
☐ Community
☐ Public


Comments:

Comments:

INITIAL SITE SKETCH

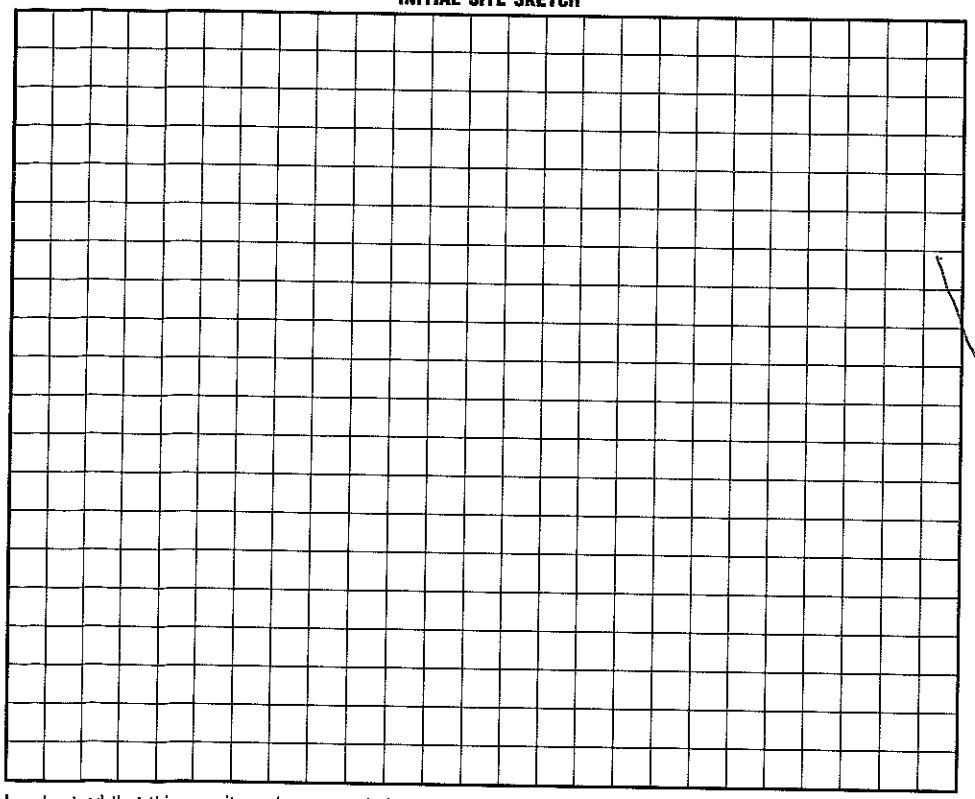

AS BUILT SKETCH

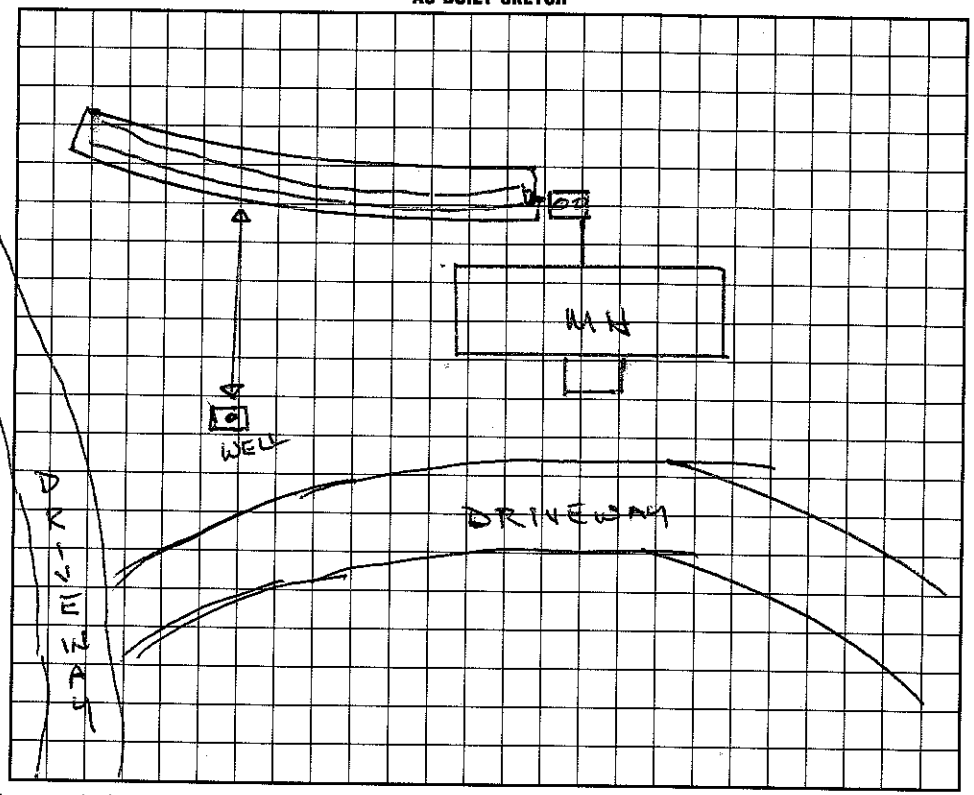

I understand that this permit can be suspended or revoked if any false information is supplied toward securing the permit/any unauthorized changes are made to the site/any unauthorized changes are made in the installation of the system. Improvement Permit is valid for 60 months from date of issuance.

Signed: _____

Improvement Permit by: _____ date _____

Existing System Inspection by: Wesley Parks R.S. date 4/19/00

Installed by: _____

Certificate of Completion by: _____ date _____

Operation Permit by: _____ date _____

HEALTH DEPT. COPY: WHITE INSPECTION COPY (FINAL): GREEN OWNER COPY (FINAL): YELLOW INSPECTION COPY (INITIAL): PINK OWNER COPY (INITIAL): GOLD