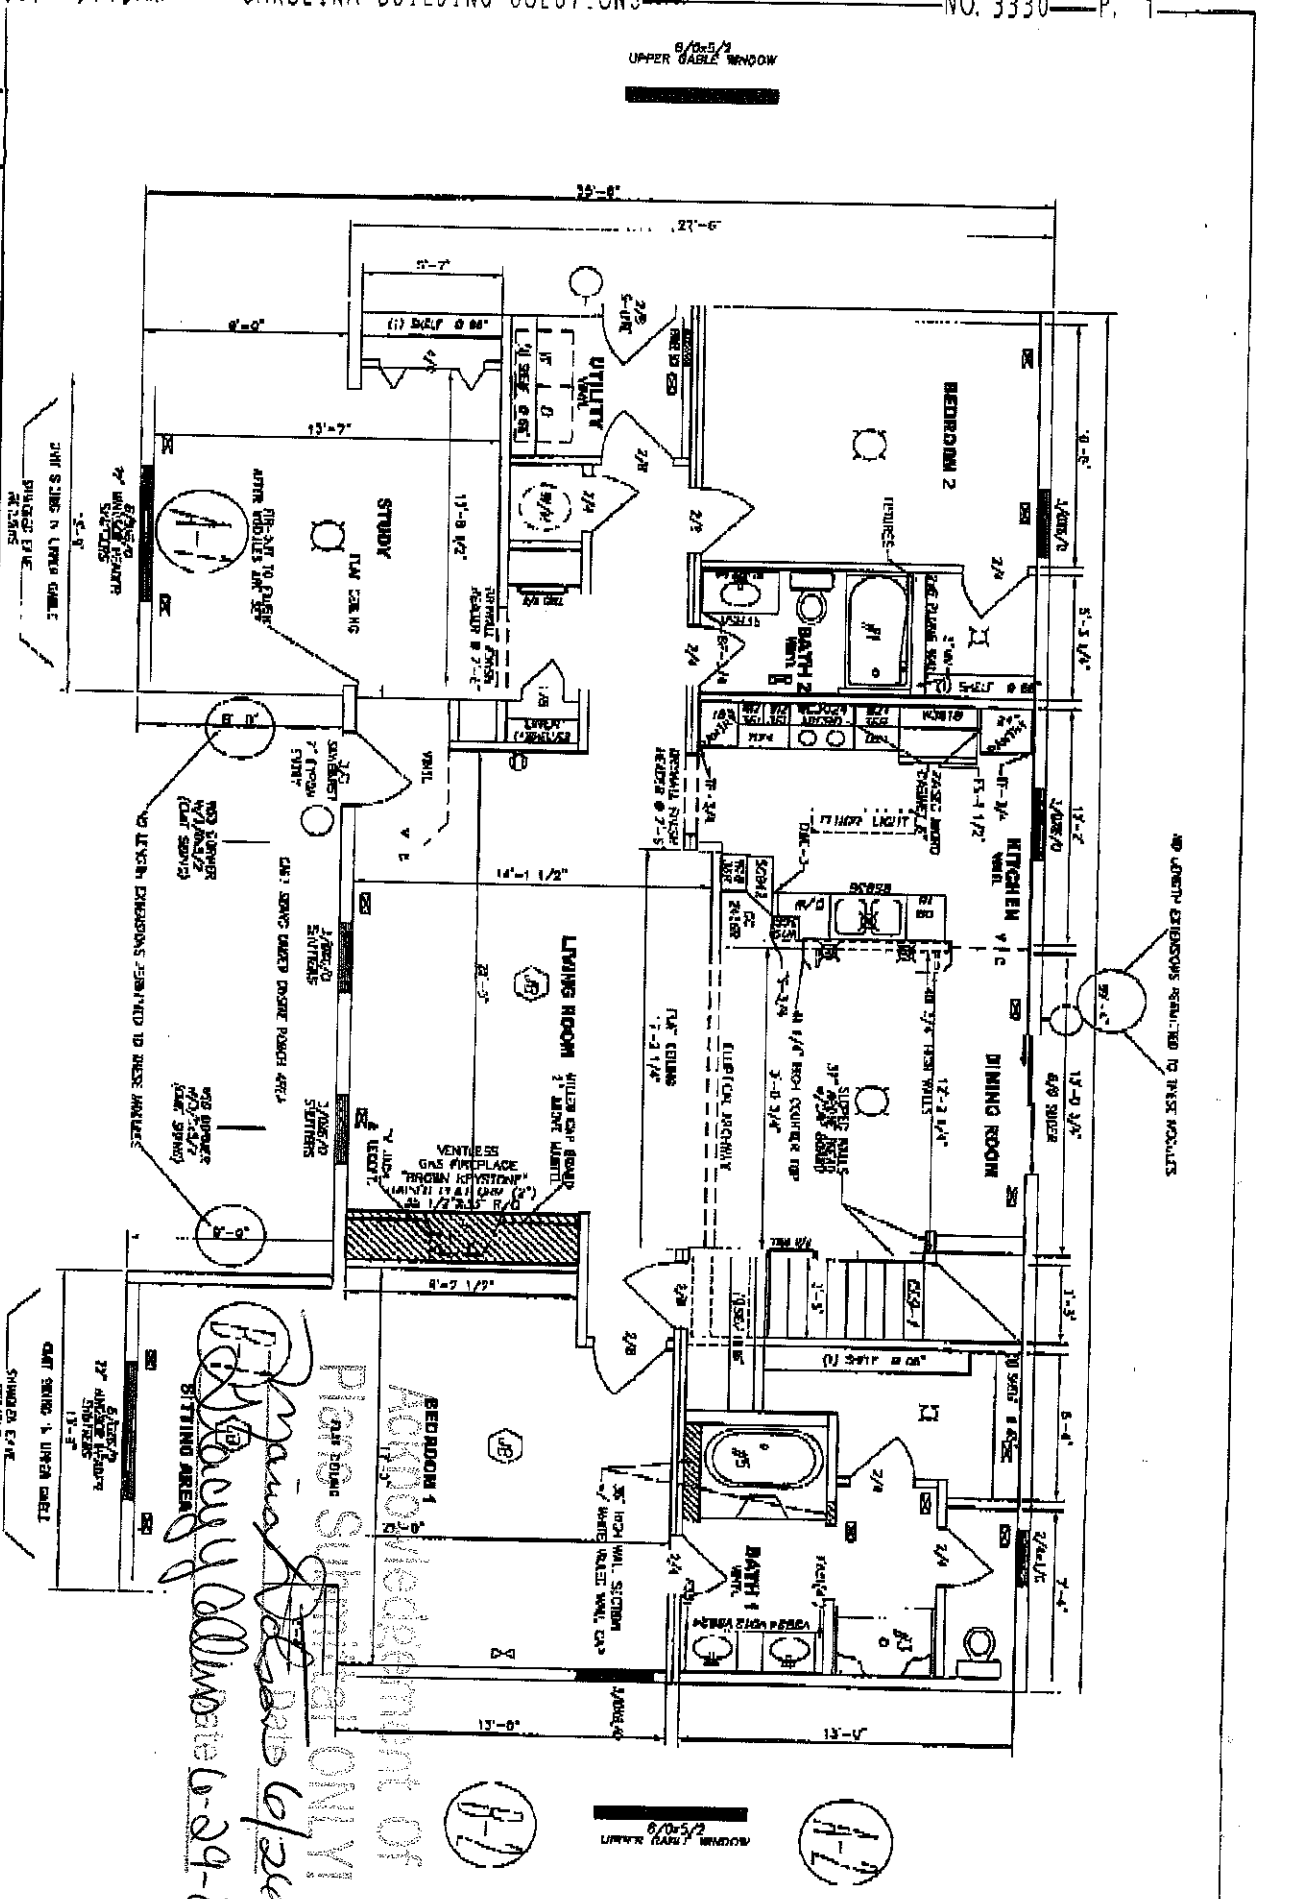


carolina building solutions
INNOVATIVE HOME BUILDING SYSTEMS
www.cbsmsng.com

MARRIAGE & SIDE WALLS	SERIAL NO. 2374
CS-1852-GC	PROP NO. 3394
BUILDER: CROSSLAND HOMES	WIND ZONE 100 (ASD)
RETAIL: MODEL	DEL'ST. MC
35'-6" x 53'-4"	CODE: IRC
SCALE: N.T.S.	MBR.LIV./RM. DATE: 12/21/04
CAPE COD	

PLAN SPECS.

ROOF PITCH	12/12
ROOF CENTERS	24" o.c.
SIDE WALL HEIGHT	108"
EXTERIOR WALLS	2x6 o.c.
INTERIOR WALLS	2x6 o.c.

PLAN NOTES:
** SEE JOB SPECIFICATIONS

2X3 MATE WALLS @ 16" o.c.
3/4" ATTIC DECKING

Approved as Noted
Plans Shall Conform to All Applicable Codes
Date 6/26/07
By [signature]
Permit Number 6-29-07

PAGE NO. 6