IREDELL COUNTY HEALTH DEPARTMENT

STATESVILLE 704-878-5305 MOORESVILLE 704-664-5281

IMPROVEMENT PERMIT / CERTIFICATE OF COMPLETION / OPERATION PERMIT / EXISTING SYSTEM INSPECTION

PROPERTY DESCRIPTION NO. 20382 DATE 7/24/95 TAX MAP NO. 2D-B-76 Pt of F Watershed: [X] Yes [ ] No

OWNER OR CONTRACTOR Carl Tompkins PHONE: Business 4648-34-0004 Home 873-3673

ADDRESS 900 Shinnell Rd. Mooresville, NC. 28115

LOCATION Big Indian Lp. off Bluefield (R) on Big Indian second curve ~.3 mile on (L)

SUBDIVISION Indian Hills BLOCK / SECTION III LOT 35 LOT AREA .76 AC SITE CLASS PS DESIGN FLOW 360 L.T.A.R. .3

Septic Tank: 1000 Gallons; STB 825 Date 10/16/95
Pump Tank: _____ Gallons; PT _____ Date _____
Pump Make: _____ Model _____ Serial No. _____
Nitrification Field: No Fields 1 Square Feet 1200 Linear Feet 400
No Lines X3 Trench Width 36" Max Trench Bottom Depth 36" Gravel Depth 12"

[X] New System [ ] Repair System Type: I (II) III, IV, V, VI
System Description: CONV - DIST BOX
Repair System Description: GRAVITY PANEL
Maintenance Agreement Required: [ ] Yes [X] No


[X] House/Mod. Home No. Bedrooms 3
[ ] Mobile Home No. Bathrooms 2
[ ] Business No. Employees _____
[ ] Other _____
[ ] Slab [X] Crawl Space [ ] Basement w/plumbing [ ] Basement wo/plumbing

Water Supply:
[X] Individual
[ ] Community
[ ] Public

Comments: Trenches on slope contour - Be careful
Speed loaders required

Comments:
3@ 133' x 3' constructed

INITIAL SITE SKETCH

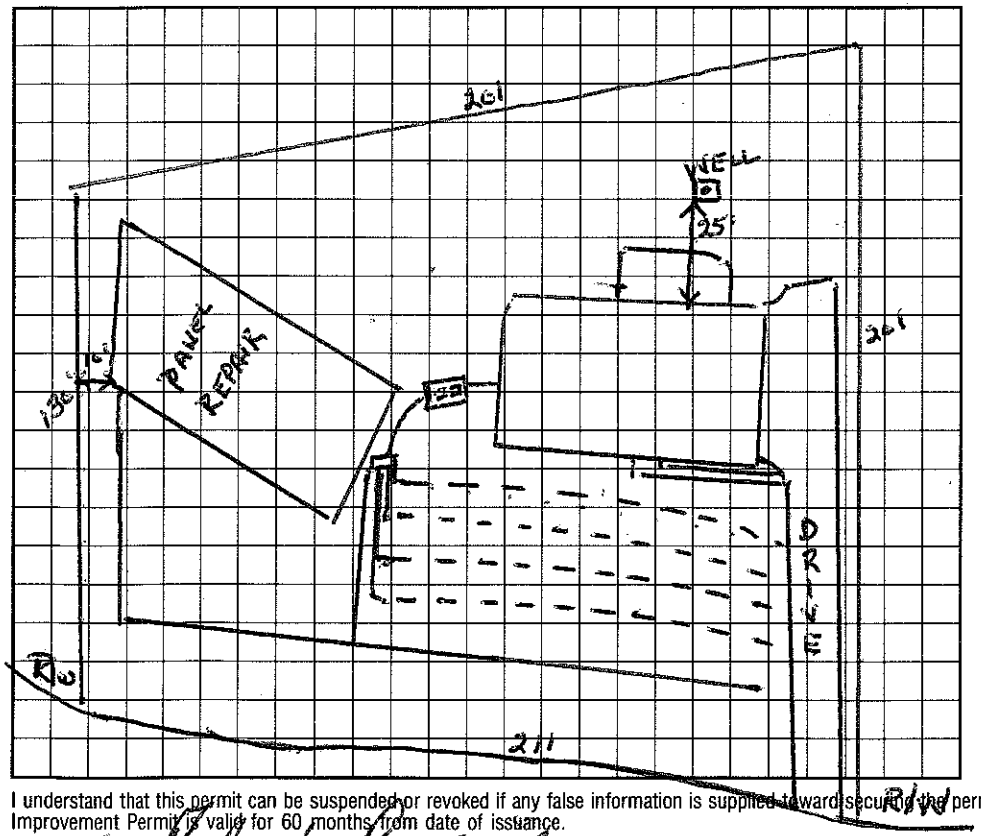

AS BUILT SKETCH

I understand that this permit can be suspended or revoked if any false information is supplied toward securing the permit/any unauthorized changes are made to the site/any unauthorized changes are made in the installation of the system. Improvement Permit is valid for 60 months from date of issuance.

Signed: Robert Lindsay

Improvement Permit by: Wesley Sparks R.S. date 7/24/95

Existing System Inspection by: _____ date _____

Installed by: Delbert Bentley

Certificate of Completion by: Wesley Sparks R.S. date 11/21/95

Operation Permit by: Wesley Sparks R.S. date 11/21/95

HEALTH DEPT. COPY: WHITE INSPECTION COPY (FINAL): GREEN OWNER COPY (FINAL): YELLOW INSPECTION COPY (INITIAL): PINK OWNER COPY (INITIAL): GOLD