IREDELL COUNTY HEALTH DEPARTMENT

Statesville Office (704) 878-5305 Mooresville Office (704) 660-3625 PERMIT # 200671

IMPROVEMENT PERMIT / AUTHORIZATION TO CONSTRUCT / OPERATION PERMIT / EXISTING SYSTEM

PIN # 4648-34-0714.000

APPLICANT: Johnathan Taylor APPLICANT ADDRESS: 7242 Sigmon Rd. Sherrills Ford NC

SITE ADDRESS: 119 Churchhill Ln. Mooresville NC PHONE: 704-506-2023 ALT. PHONE:

SITE DIRECTIONS: Bluefield to Big Indian Lp, TR at fork, TR Churchhill, site on L


SUBDIVISION: CLT SECTION: 12 LOT # 67 LOT AREA: .74 acre DESIGN FLOW: 360 GPD L.T.A.R.: .3

Septic Tank	1000 (gal)	STB	794	Date	1/6/15	☒ New System	☐ Repair	☐ Expansion	System Type: I II III IV V VI	☒ Residence	No. Bedrooms 3
Pump Tank	1000 (gal)	PT	283	Date	1/12/14	System Description: 25% Reduction - Pump				☐ Business	No. Persons 6
Pump Make	Zoeller	Model	N-1523	Serial #	152-0002	Repair System Description: LPPPBPS - Pretreated				☐ Other	No. Employees
# Nitrification Fields	1	# Lines	4	Linear Ft:	320'	Maintenance Agreement Required:	☐ YES	☒ NO		☐ Slab	☐ Crawl Space
Trench Width	36"	Max. Trench Bottom Depth	30"	Gravel Depth	N/A		☐ GRAVITY	☒ PRESSURE		☒ Basement w/plumbing	☐ Basement w/o plumbing

Water Supply: ☒ Private ☐ Public ☐ Community

Comments / Conditions: If Cover Exceeds 36" on Tanks, Traffic Rated Tanks Must Be Used. Maintain 50' From Well With Any Septic Components. Maintain 15' Separation From Basement With Drainfield And Tanks And At Least 5' From Any Building Structures (Deck). Supply Line And Drainfield Can Be 5' From Property Line. Crush And Fill Old Tank And Earthen Dam


INITIAL SITE SKETCH

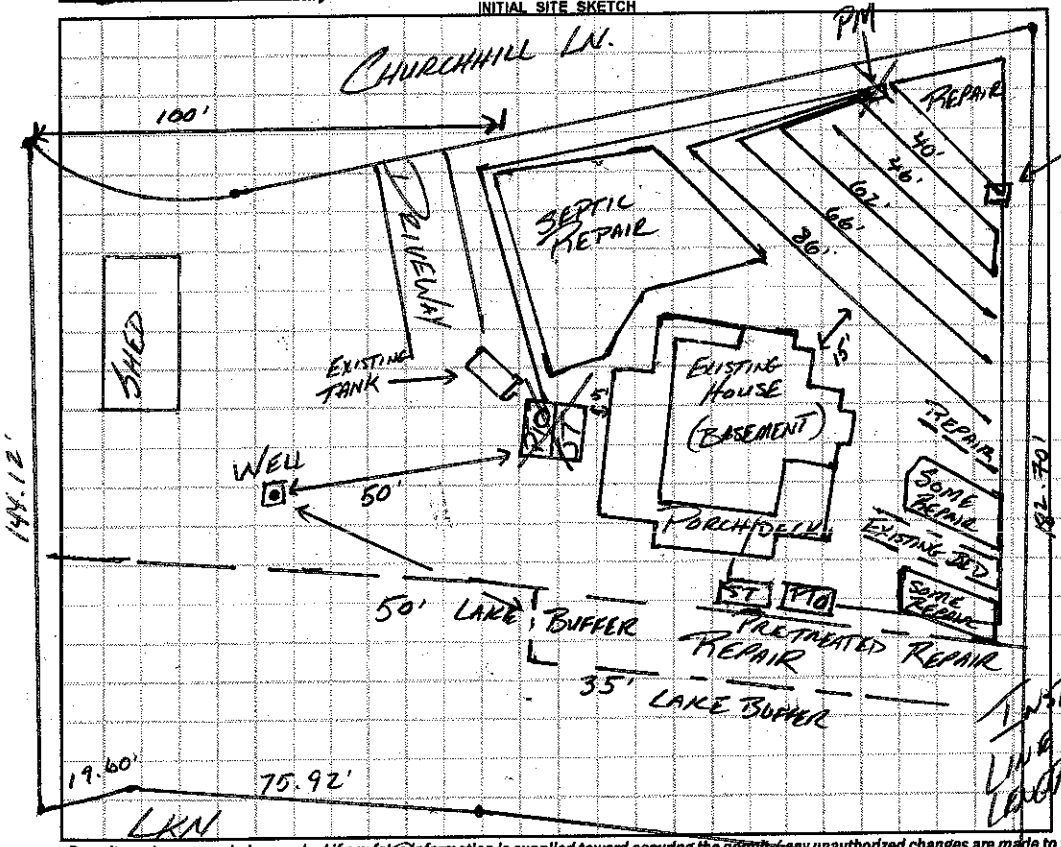

AS BUILT SKETCH

1"=40'

Existing Bed 15' from Basement.

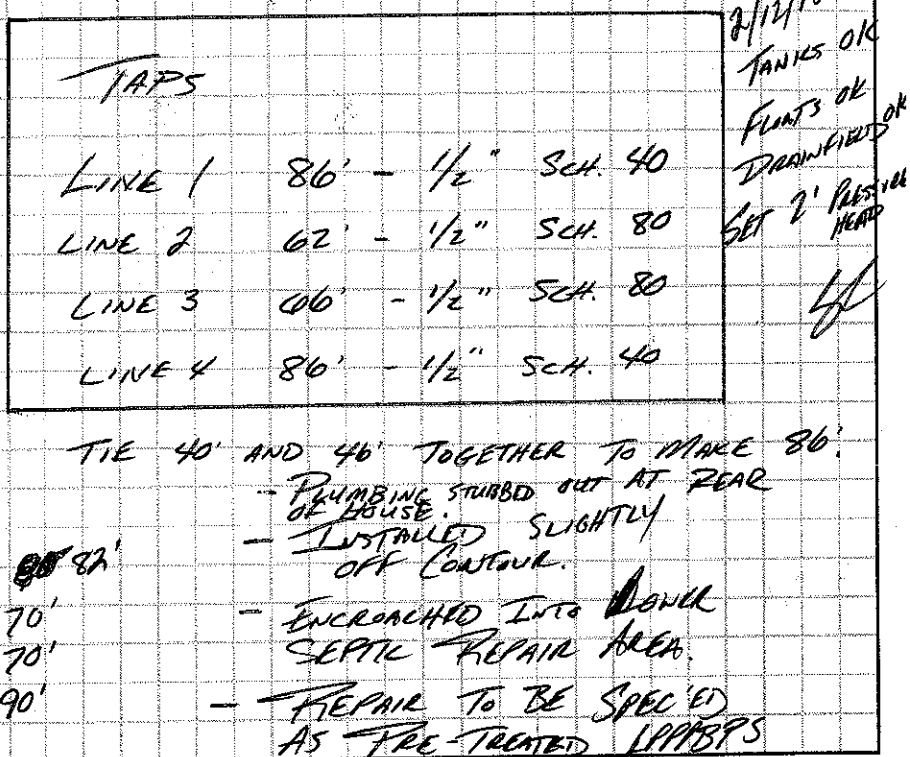

2/12/15
Tanks OK
Floats OK
Drainfield OK
Set 2' Pressure Head

Permit can be suspended or revoked if any false information is supplied toward securing the permit / any unauthorized changes are made to the site / any unauthorized changes are made in the installation of the system. **CONTACT A LOCATOR SERVICE PRIOR TO ANY EXCAVATION**

☐ **IMPROVEMENT PERMIT** *with plat valid without expiration.* ☒ **IMPROVEMENT PERMIT** *with site plan valid for 60 mos.* ☒ **AUTHORIZATION TO CONSTRUCT** *valid for period equal to IMPROVEMENT PERMIT--not to exceed 60 mo.*

Owner / Applicant Signature: Date: 2/6/15 Installed by: Ken Dellinger

IMPROVEMENT PERMIT by: APPROVED FEB 05 2015 OPERATION PERMIT by: APPROVED MAY 15 2015 Date:

AUTHORIZATION TO CONSTRUCT by: APPROVED FEB 05 2015 Existing System Inspected by: Date:

Health Dept. Copy - WHITE Applicant (Final Approval) - YELLOW Applicant (Conditional Approval) - PINK