IREDELL COUNTY HEALTH DEPARTMENT

STATESVILLE 704-878-5305 MOORESVILLE 704-664-5281

IMPROVEMENT PERMIT / AUTHORIZATION TO CONSTRUCT / OPERATION PERMIT / EXISTING SYSTEM INSPECTION

PERMIT# 072202 PIN# 4648 34 1676 DATE 3/21/98

OWNER OR CONTRACTOR Larry Day PHONE: Business (704) 782-5946 Home

ADDRESS 158 Goodman Circle Concord, NC 28025

LOCATION Big Indian Loop TR Churchill Ln 1st lot on left

SUBDIVISION M & T BLOCK SECTION 2 LOT 66 LOT AREA ~3/4 Acre SITE CLASS. DESIGN FLOW 360gpd L.T.A.R. 3 Existing

Septic Tank: 1000 Gallons; STB Date

Pump Tank: Gallons; PT Date

Pump Make: EXISTING Model Serial No.

Nitrification Field: No Fields Square Feet Linear Feet

No Lines Trench Width Max Trench Bottom Depth Gravel Depth

☐ New System ☐ Repair System Type: I, II, III, IV, V, VI

System Description: Gravity Conv) Existing

Repair System Description:

Maintenance Agreement Required: ☐ Yes ☐ No

☐ House/Mod. Home No. Bedrooms 3

☒ Mobile Home No. Bathrooms

☐ Business No. Employees

☐ Other

☐ Slab ☒ Crawl Space ☐ Basement w/plumbing ☐ Basement wo/plumbing


Water Supply: ☒ Individual ☐ Public ☐ Community

Comments:/Conditions: Septic System working okay At time of inspection, No problems noticed. (System originally installed 4-14-77.


Comments:/Conditions: Upgrading from 3 Bdrm MH to 3 Bdrm House. System originally sized for 3 Bdrms, okay to replace with 3 Bdrms.

Not to Scale

INITIAL SITE SKETCH PL 220'

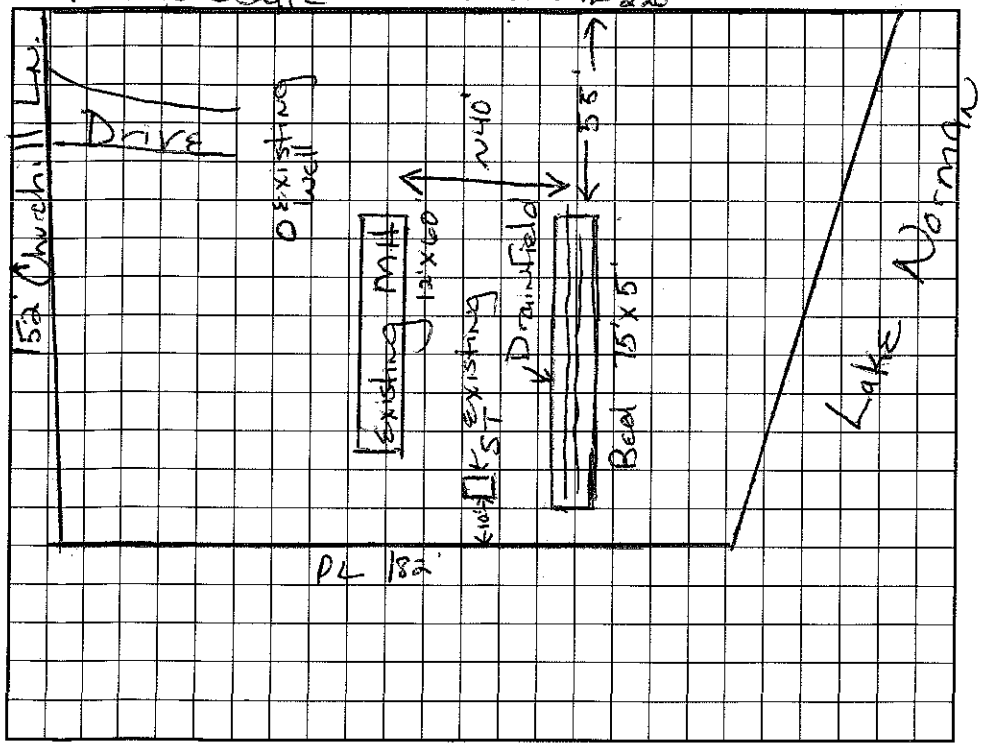

AS BUILT SKETCH

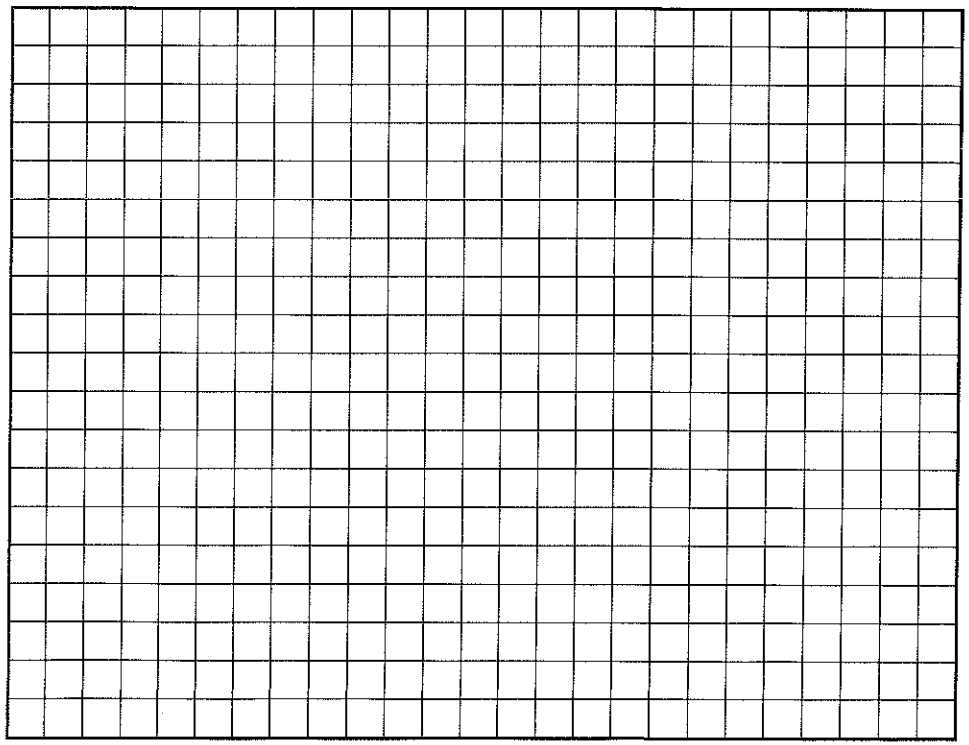

I understand that this permit can be suspended or revoked if any false information is supplied toward securing the permit/any unauthorized changes are made to the site/any unauthorized changes are made in the installation of the system. Improvement Permit with plat valid without expiration. Improvement Permit with site plan valid for sixty months. Authorization to Construct is valid for a period equal to that of Improvement Permit – not to exceed sixty months.

Signed: Larry Wilson date

Improvement Permit by: Maina M. Johnson date 3/21/98

Authorization to Construct by: Maina M. Johnson date 3/21/98

Installed by:

Operation Permit by: date

Existing System Inspection by: date

HEALTH DEPT. COPY - WHITE INSPECTION COPY (FINAL): GREEN OWNER COPY (FINAL): YELLOW INSPECTION COPY (INITIAL): PINK OWNER COPY (INITIAL): GOLD

Existing System