704-478-9928

IREDELL COUNTY HEALTH DEPARTMENT

STATESVILLE 704-878-5305 MOORESVILLE 704-664-5281

IMPROVEMENT PERMIT / AUTHORIZATION TO CONSTRUCT / OPERATION PERMIT / EXISTING SYSTEM INSPECTION

PERMIT# 070937 PIN# 4648346058 DATE 4/3/98

OWNER OR CONTRACTOR DAN McGRAW PHONE: Business Home 663-4914

ADDRESS 533 BIG INDIAN LOOP MOORESVILLE NC 28117

LOCATION BLUEBIRD - TL BIG INDIAN - TR 1ST BIG INDIAN - ~ 1 MILE ON LT.

SUBDIVISION INDIAN HILLS BLOCK / SECTION 3 LOT 33 LOT AREA ~3AC SITE CLASS. PS DESIGN FLOW 360GPD L.T.A.R. .3600/FT²

Septic Tank: 1000 Gallons; STB 1012 Date 6/15/98

Pump Tank: 1000 Gallons; PT 17 Date 12/12/97

Pump Make: HYDROMATIC Model SR50A1 Serial No.

Nitrification Field: No Fields 1 Square Feet 1200 Linear Feet 400

No Lines 4@100' Trench Width 36" Max Trench Bottom Depth 24" Gravel Depth 12"

☑ New System ☐ Repair System Type: I, II, III, IV, V, VI

System Description: PUMP CONVENTIONAL

Repair System Description: PUMP CHAMBERS OR HDS

Maintenance Agreement Required: ☐ Yes ☑ No

☑ House/Mod. Home No. Bedrooms 3

☐ Mobile Home No. Bathrooms 2

☐ Business No. Employees

☐ Other

☐ Slab ☑ Crawl Space ☐ Basement w/plumbing ☐ Basement wo/plumbing


Water Supply: ☑ Individual ☐ Public ☐ Community

Comments:/Conditions:

Comments:/Conditions:

(CHANGED TO CHAMBERED SYSTEM 300')

INITIAL SITE SKETCH

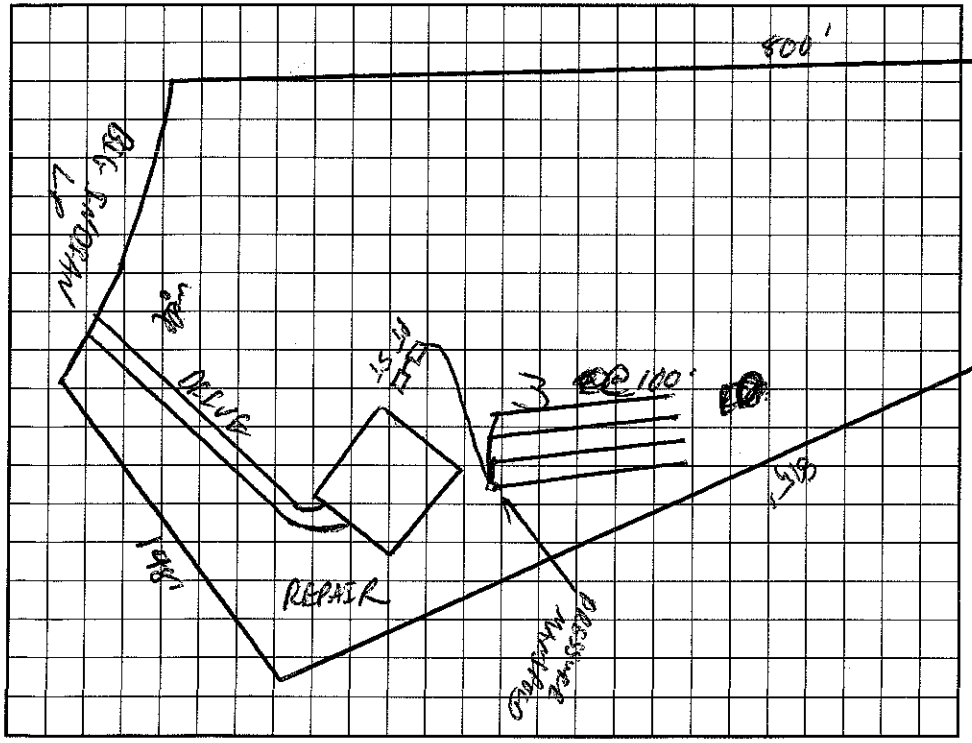

AS BUILT SKETCH

I understand that this permit can be suspended or revoked if any false information is supplied toward securing the permit/any unauthorized changes are made to the site/any unauthorized changes are made in the installation of the system. Improvement Permit with plat valid without expiration. Improvement Permit with site plan valid for sixty months. Authorization to Construct is valid for a period equal to that of Improvement Permit – not to exceed sixty months.

Signed: David W. Martin date 4/6/98

Improvement Permit by: C. Mayfield date 4/3/98

Authorization to Construct by: C. Mayfield date 4/3/98

Installed by: A1 BACKHOE

Operation Permit by: C. Mayfield date 5/29/99

Existing System Inspection by: date

HEALTH DEPT. COPY: WHITE INSPECTION COPY (FINAL): GREEN OWNER COPY (FINAL): YELLOW INSPECTION COPY (INITIAL): PINK OWNER COPY (INITIAL): GOLD