IREDELL COUNTY HEALTH DEPARTMENT

→ Authorization to Construct

STATESVILLE 704-878-5305 MOORESVILLE 704-664-5281

IMPROVEMENT PERMIT / ~~CERTIFICATE OF COMPLETION~~ / OPERATION PERMIT / EXISTING SYSTEM INSPECTION

PROPERTY DESCRIPTION NO. 21658 DATE 11/7/95 TAX MAP NO. 2P 6831 Watershed: [X] Yes [ ] No

OWNER OR CONTRACTOR Harold Henderson ~~PHONE: Business~~ 4648-34-8573 Home 298-3857

ADDRESS 14 N Pershing Rd. Statesville, NC. 28805

LOCATION Bluefield Rd off 150 W (L) Big Bethel Church, 1st R ~ .6 mile on (L) past Church Hill Ln.

SUBDIVISION Hendon Hill BLOCK / SECTION 3 LOT 31 LOT AREA ~ 1.83 Ac SITE CLASS. PS DESIGN FLOW 360 L.T.A.R. .3

Septic Tank: 1000 Gallons; STB 794 Date 9-22-97

Pump Tank: ____ Gallons; PT ____ Date ____

Pump Make: ____ Model ____ Serial No. ____

Nitrification Field: No Fields 1 Square Feet 1200 Linear Feet *300

No Lines 4 V Trench Width 36" Max Trench Bottom Depth 32" Gravel Depth 6" SAND

[X] New System [ ] Repair System Type: I, II, (III) IV, V, VI

System Description: Drip w/ Infiltration

Repair System Description: ____

Maintenance Agreement Required: [ ] Yes [X] No

[X] House/Mod. Home No. Bedrooms 3

[ ] Mobile Home No. Bathrooms 2

[ ] Business No. Employees ____

[ ] Other ____


[ ] Slab [X] Crawl Space [ ] Basement w/plumbing [ ] Basement wo/plumbing

Water Supply: [X] Individual [ ] Community [ ] Public


Comments: 6" Sand in bottom of trench to seat Infiltrator Panels

Comments:

INITIAL SITE SKETCH

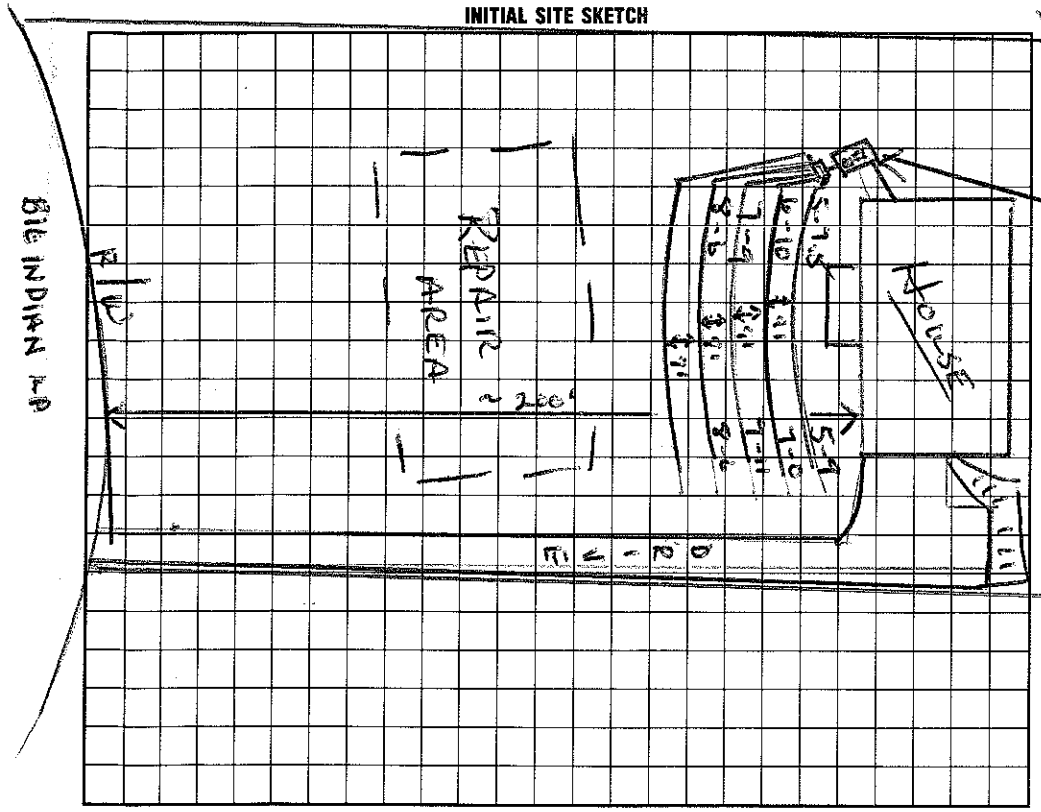

AS BUILT SKETCH

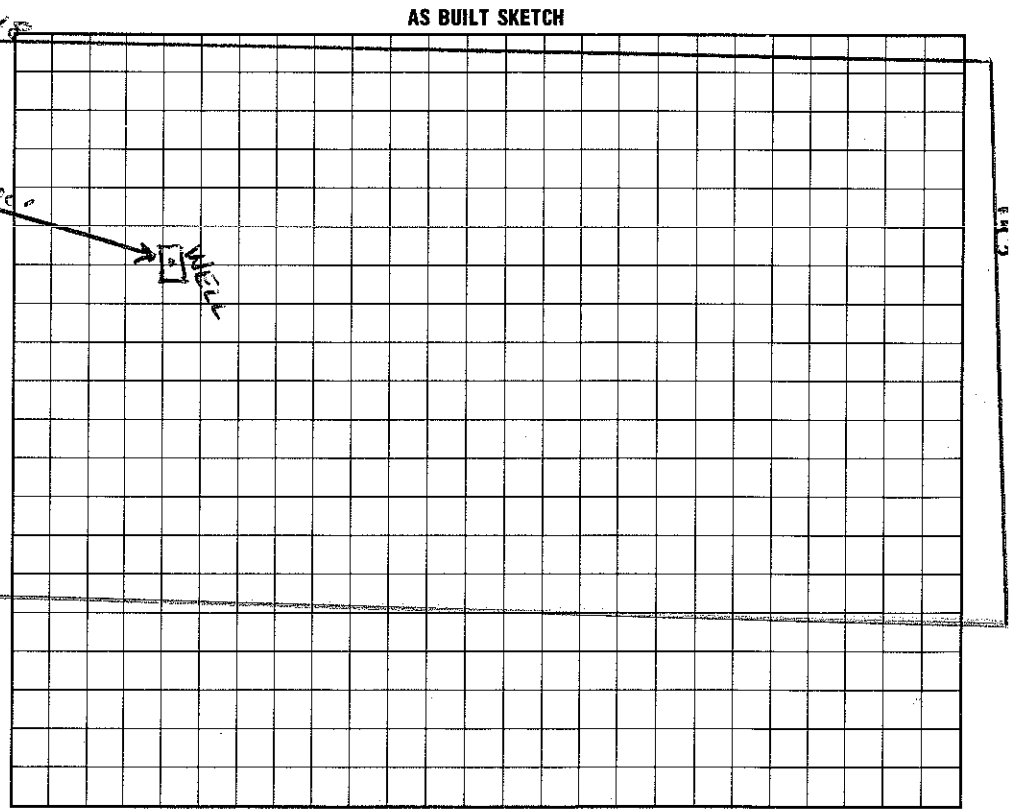

I understand that this permit can be suspended or revoked if any false information is supplied toward securing the permit/any unauthorized changes are made to the site/any unauthorized changes are made in the installation of the system.

Signed: * James S. Cooper

Improvement Permit by: Wesley Sparks RS date 11/7/95

Authorization to Construct: Wesley Sparks RS date 11/7/95

Existing System Inspection by: ____ date ____

Installed by: TW Dunaway

Certificate of Completion by: Wesley Sparks RS date 11/6/97

Operation Permit by: Wesley Sparks RS date 11/6/97

HEALTH DEPT. COPY: WHITE INSPECTION COPY (FINAL): GREEN OWNER COPY (FINAL): YELLOW INSPECTION COPY (INITIAL): PINK OWNER COPY (INITIAL): GOLD