(1:30) -

IREDELL COUNTY HEALTH DEPARTMENT

STATESVILLE 704-878-5305 MOORESVILLE 704-664-5281

IMPROVEMENT PERMIT / CERTIFICATE OF COMPLETION / OPERATION PERMIT / EXISTING SYSTEM INSPECTION

PROPERTY DESCRIPTION NO. 21637 DATE 7/31/95 TAX MAP NO. 2P 6B 44 4648 34 8615 Watershed: [X] Yes [ ] No

OWNER OR CONTRACTOR John Keever PHONE: Business _____ Home 664-6721

ADDRESS 835 Rebecca Jane Mooresville, NC. 28115

LOCATION 150 W TR Bluefield Rd TL Big Indian Lp. (R) to first lot on (L) past Churchill Ln.

SUBDIVISION Indian Hills BLOCK / SECTION 3 LOT 44 LOT AREA 1.49AC SITE CLASS. PS DESIGN FLOW 360 L.T.A.R. .3

Septic Tank: 1000 Gallons; STB 1012 Date 3/3/98

Pump Tank: 1000 Gallons; PT 27 Date 5/2/98

Pump Make: Gould Model WE0511H Serial No. E982376

Nitrification Field: No. Fields 1 Square Feet 1200 Linear Feet 400

No. Lines 45 Trench Width 36" Max Trench Bottom Depth 36" Gravel Depth 12"

[X] New System [ ] Repair System Type: I, II, (III) IV, V, VI

System Description: Pres. Manifold Conventional

Repair System Description: None

Maintenance Agreement Required: [ ] Yes [X] No

[X] House/Mod. Home No. Bedrooms 3

[ ] Mobile Home No. Bathrooms 2.5

[ ] Business No. Employees _____

[ ] Other _____


[ ] Slab [X] Crawl Space [ ] Basement w/plumbing [ ] Basement wo/plumbing

Water Supply: [X] Individual [ ] Community [ ] Public


Comments: Bldg left 1/16/96 HWS - 9" Drawdown

Comments: 4:00 .cl

INITIAL SITE SKETCH

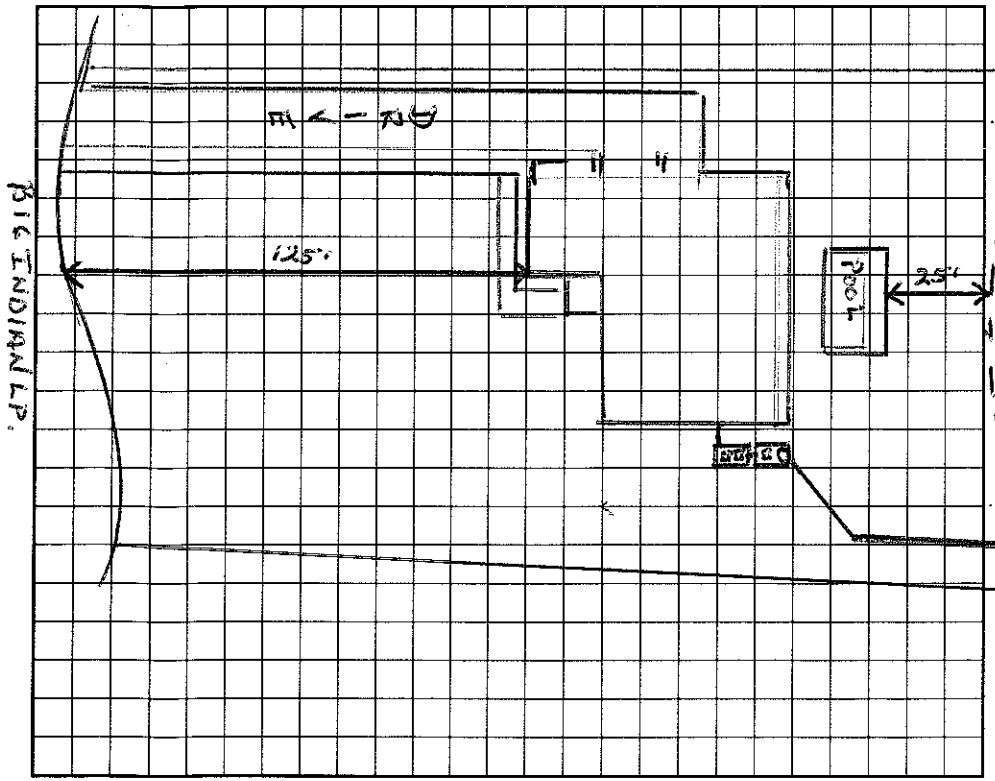

AS BUILT SKETCH

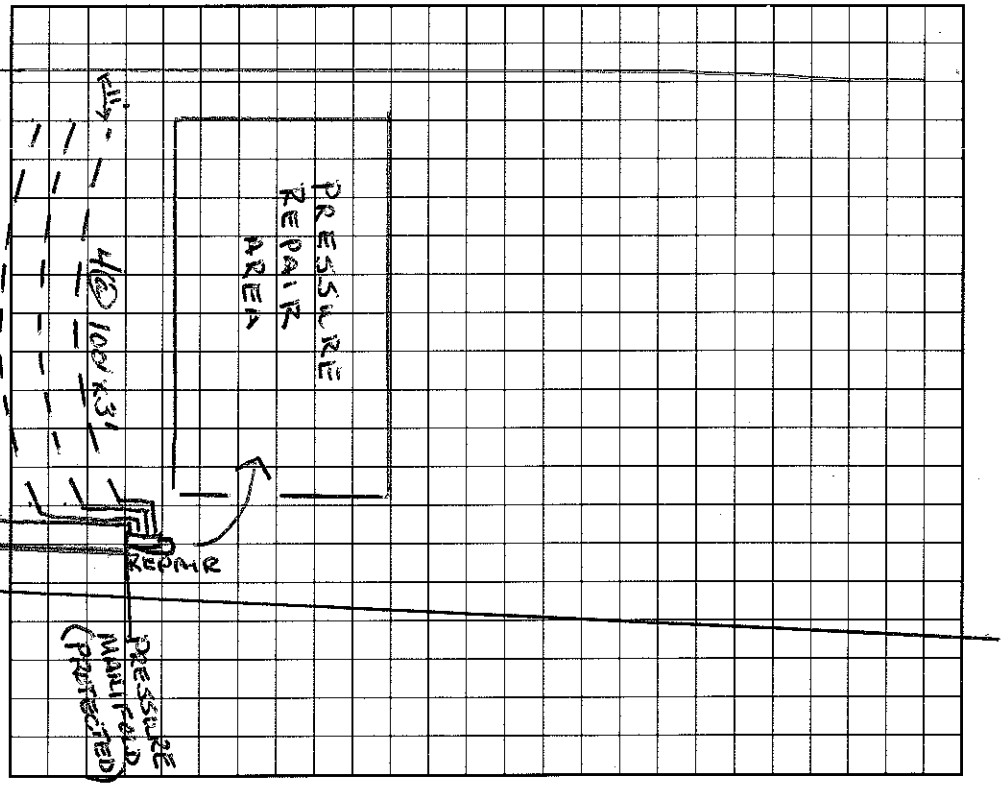

I understand that this permit can be suspended or revoked if any false information is supplied toward securing the permit/any unauthorized changes are made to the site/any unauthorized changes are made in the installation of the system.

Signed: John Keever

Improvement Permit by: Wesley Sparks RS. date 7/31/95

Existing System Inspection by: _____ date _____

Installed by: David Yount

Certificate of Completion by: Wesley Sparks RS. date 6/25/98

Operation Permit by: Wesley Sparks RS. date 6/25/98

HEALTH DEPT. COPY: WHITE INSPECTION COPY (FINAL): GREEN OWNER COPY (FINAL): YELLOW INSPECTION COPY (INITIAL): PINK OWNER COPY (INITIAL): GOLD