IREDELL COUNTY HEALTH DEPARTMENT


STATESVILLE 704-878-5305 MOORESVILLE 704-664-5281

IMPROVEMENT PERMIT / ~~CERTIFICATE OF COMPLETION~~ / OPERATION PERMIT / EXISTING SYSTEM INSPECTION

PROPERTY DESCRIPTION NO. 22262 DATE 12/11/95 TAX MAP NO. 2P 6 B 32 4648 34 9371 Watershed: ☒ Yes ☐ No

OWNER OR CONTRACTOR Kyle F Rogers PHONE: Business _____ Home 664-9519

ADDRESS PO Box 6054 Mooresville, NC. 28115

LOCATION Big Indian Lp., TR ~ .7 mile on (L)

SUBDIVISION Indian Hill BLOCK / SECTION PH III LOT 32 LOT AREA ~ 11.5 Ac SITE CLASS. P.S DESIGN FLOW 480 L.T.A.R. .3

Septic Tank: 1600 Gallons; STB _____ Date _____

Pump Tank: 1000 Gallons; PT _____ Date _____

Pump Make: GOULDS Model WE0 712H Serial No. 9653933

Nitrification Field: No Fields 1 Square Feet 1600 Linear Feet 400X

No Lines 4 Trench Width 36" Max Trench Bottom Depth 36" Gravel Depth 6" SAND

☒ New System ☐ Repair System Type: I, II, III, IV, V, VI

System Description: PRES INFILTRATOR

Repair System Description: SAME

Maintenance Agreement Required: ☒ Yes ☐ No

☒ House/Mod. Home ☐ Mobile Home ☐ Business ☐ Other

No. Bedrooms 4 No. Bathrooms 3.5 No. Employees _____

☐ Slab ☐ Crawl Space ☒ Basement w/plumbing ☐ Basement wo/plumbing

Water Supply: ☒ Individual ☐ Community ☐ Public


Comments: ~~4~~ INFILTRATOR DRAINFIELD

523


Comments:

Installed as designed.

INITIAL SITE SKETCH

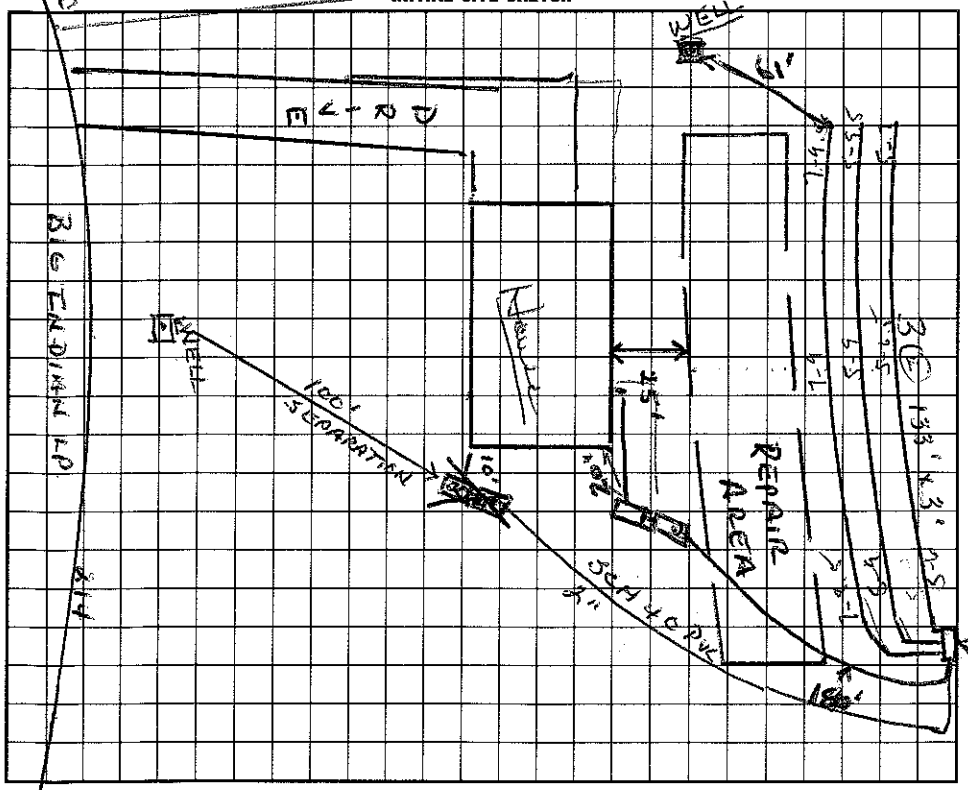

AS BUILT SKETCH

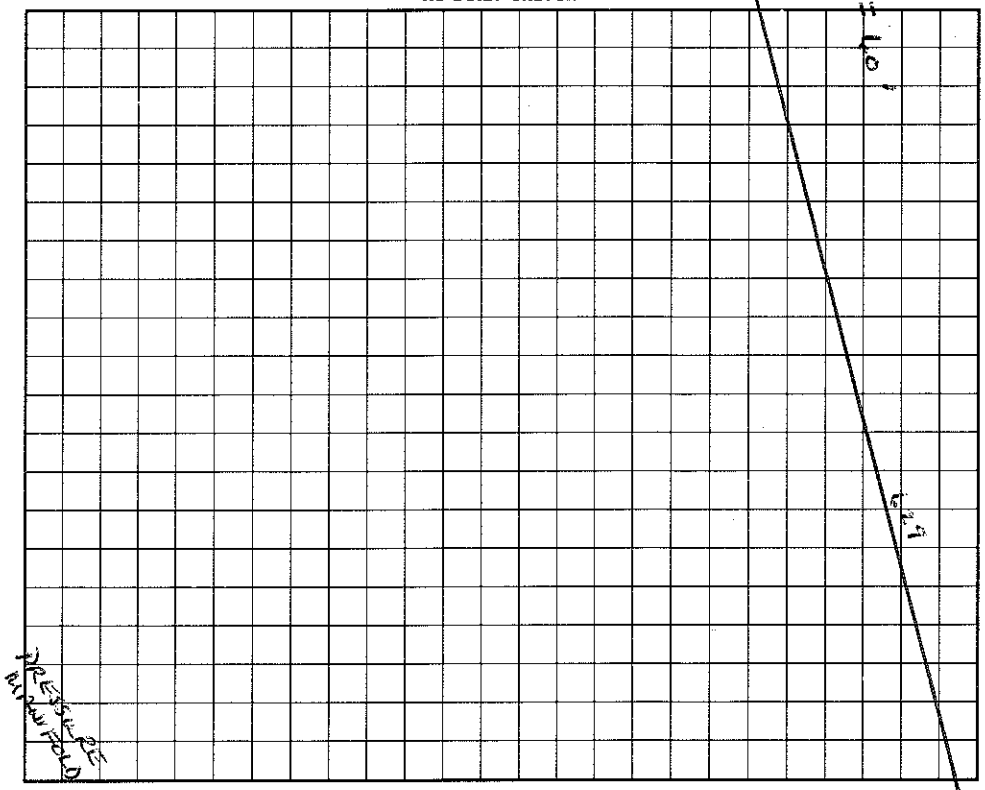

I understand that this permit can be suspended or revoked if any false information is supplied toward securing the permit/any unauthorized changes are made to the site/any unauthorized changes are made in the installation of the system.

Signed: Mark J. Jay

Improvement Permit by: Wesley Sparks RS. date 12/11/95

~~Certificate of Completion by:~~ Wesley Sparks RS. date 12/11/95

Existing System Inspection by: _____ date _____

Installed by: F J Ervin

Certificate of Completion by: _____ date _____

Operation Permit by: Wesley Sparks RS. date 10/22/96

HEALTH DEPT. COPY: WHITE INSPECTION COPY (FINAL): GREEN OWNER COPY (FINAL): YELLOW INSPECTION COPY (INITIAL): PINK OWNER COPY (INITIAL): GOLD